

FILED

Date: 2-6-2017 By: JC

This survey consists of:

Map: _____

Narrative: _____

Corner Rpt: CS65/95-8

DOUGLAS COUNTY
SURVEYOR

PAGE 1 OF 2

LANE COUNTY SURVEYORS OFFICE
DEPARTMENT OF PUBLIC WORKS

FILE NO: 23-01-25 W1/4

TRGCDB: 2301600240

INDEX NO: **16090**

CORNER REPORT

THE 1/4 CORNER COMMON TO SECTIONS 25 AND 26, T23S, R1W, W. M.
LOCATED ON THE LANE - DOUGLAS COUNTY LINE

DATE	1894	1960	1976
SURVEYOR	H. CHANDLER	BLM VOL R-572	V. CANGIE (DOUG. CO.)
SOURCE	GLO VOL R-379	H. CORBIN	CS FILE 59/26
MONUMENT FOUND		NO EVIDENCE OF ORIG. CORNER	UPROOTED BRASS CAP
MONUMENT SET	12x8x8 INS. BASALT STONE, MARKED "1/4" ON WEST FACE	2 1/2"x28" I. POST W/ BRASS CAP	REPLACE BRASS CAP ADD "1976"
FOOTNOTE			1
BEARING OBJECT 1	8" HEMLOCK MKD. "1/4S BT" N 79° E, 23 LKS = 15.2'		
BEARING OBJECT 2	15" HEM. MARKED "1/4S BT" S 23° W, 34 LKS = 22.4'		
BEARING OBJECT 3		44" FIR MARKED "1/4 S25 BT" S 57° E, 9 LKS = 5.9'	44" FIR STUMP W/ "BT" AT RECORD
BEARING OBJECT 4		22" HEM. MARKED "1/4 S26 BT" N 57° W, 44 LKS = 29.0'	22" HEMLOCK STUMP W/ "1/4 S2" AT RECORD
BEARING OBJECT 5			SET 5/8"x30" I. ROD W/ ALUM. CAP "BO" IN 51" FIR STUMP N 70° E, 70.9'

(BOLDDED ENTRIES IN THE ABOVE HISTORY TABLE WERE FOUND AND ARE FURTHER DESCRIBED.)

FOOTNOTES:

- 1) "Corner is in a large clearcut unit & there are no trees available for scribing"

CORNER EVIDENCE

EVIDENCE RECOVERED: AT THE CORNER POSITION FOUND A 3/4" BLM BRASS CAP FLUSH WITH THE SURFACE.
 1960 [3] A 44" FIR STUMP WITH MARKS BRS S 57° E, 5.9' TO CTR (S 57° E, 5.9').
 1960 [4] A 22" ROTTEN HEMLOCK STUMP, NO MARKS BRS N 57° W, 29.0' TO CTR (N 57° W, 29.0').

MONUMENT SET: NONE. ACCEPTED THE FOUND BRASS CAP AS MARKING THE 1/4 CORNER POSITION.

ACCESSORIES ESTABLISHED: SEE SKETCH ON PAGE 2 FOR TIES AND DESCRIPTIONS.

OTHER INFORMATION

BEARING TREES: DISTANCE SHOWN IS TO AN ALUMINUM NAIL SET AT SIDE/CENTER OF LIVE TREES.

BASIS OF BEARING: TRUE BEARINGS PER W-K COMPASS USING MAG DEC = 14 1/2° E.



GEOGRAPHIC MAP LOCATION: FOR FINDING THE CORNER AREA - NOT OF SURVEY GRADE ACCURACY
 NAD 83/91 VALUES: LATITUDE: N 43° 32' 39.8" LONGITUDE: W 122° 45' 41.9"

EQUIPMENT USED: W-K COMPASS #23157 AND STEEL TAPE.

DATE OF SURVEY: MAY 4, 2015

FIELD WORK BY: BRUCE BOTHEL, PLS, ASSOCIATE SURVEYOR 88
 STUART DUCE, PLS, ENGINEERING TECHNICIAN II

C.S. FILE 65/95-8

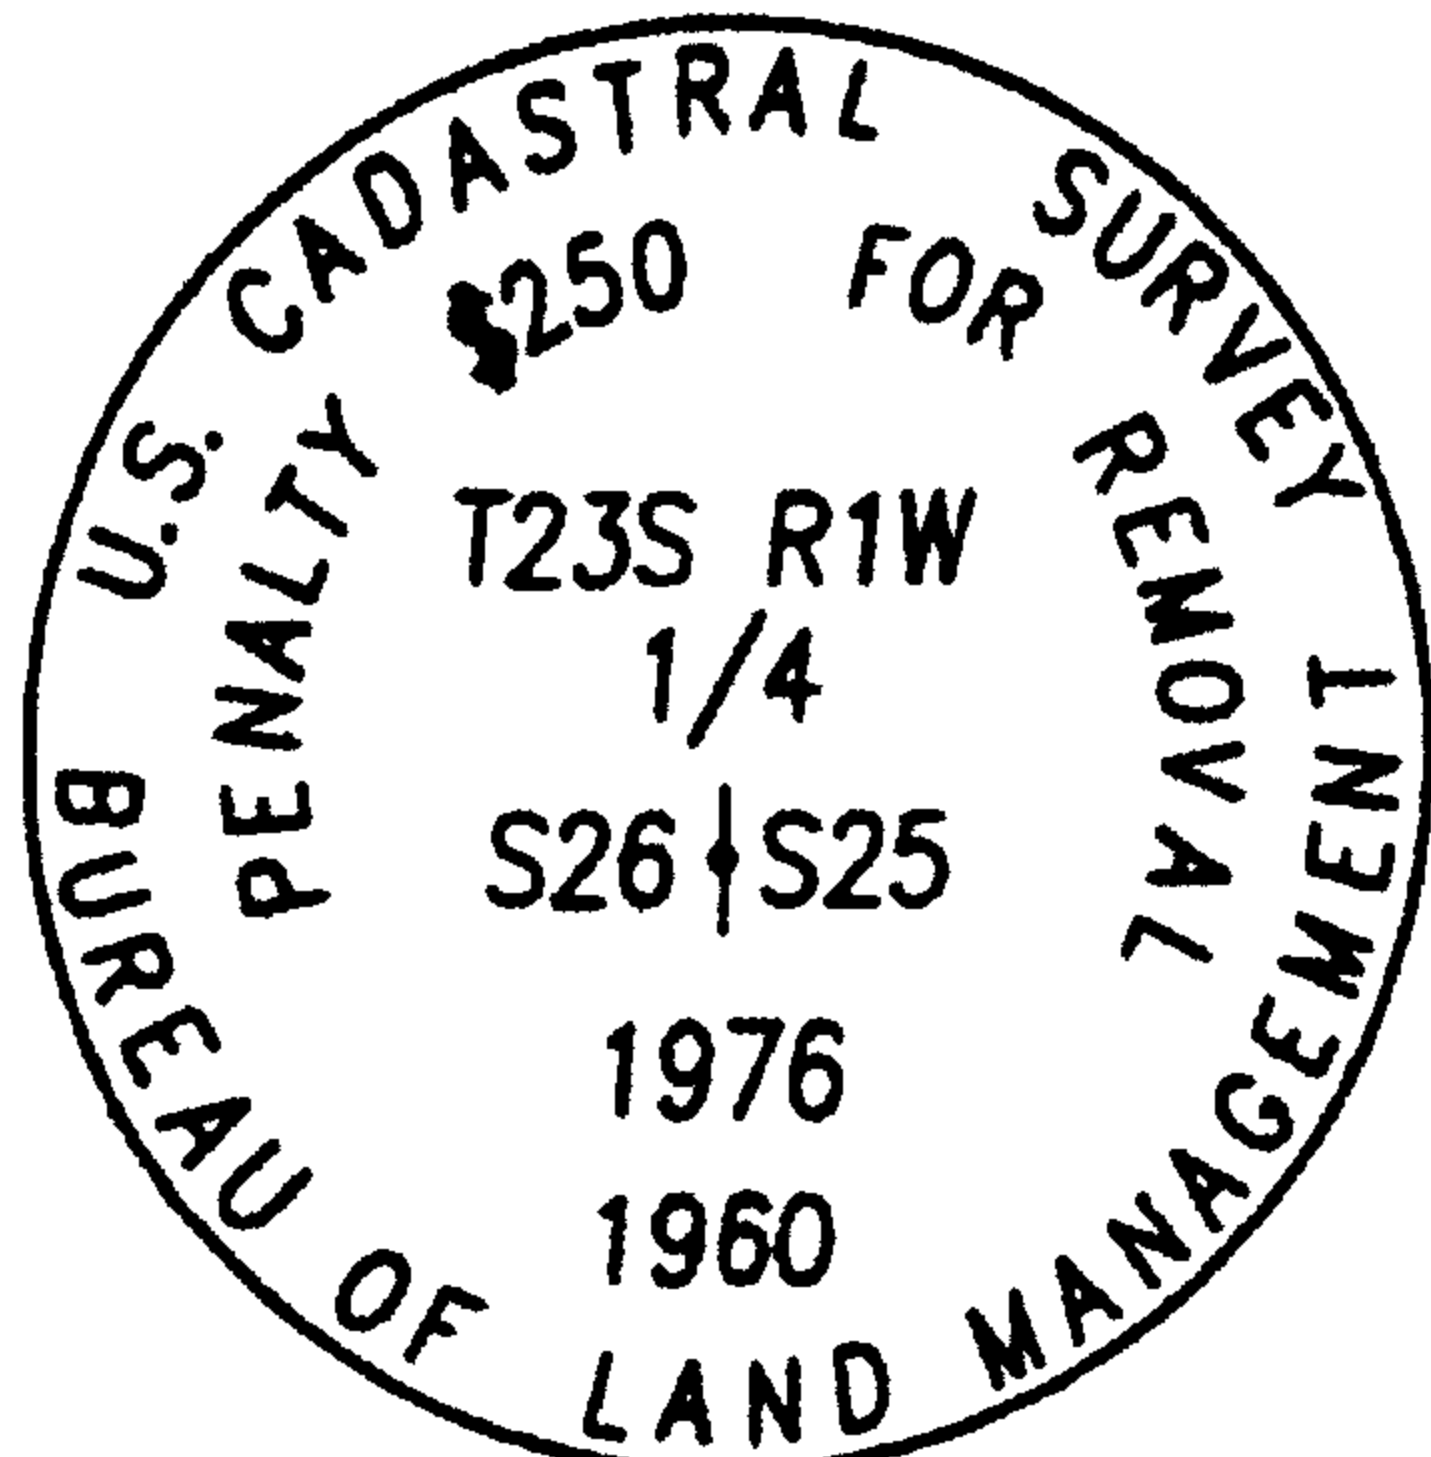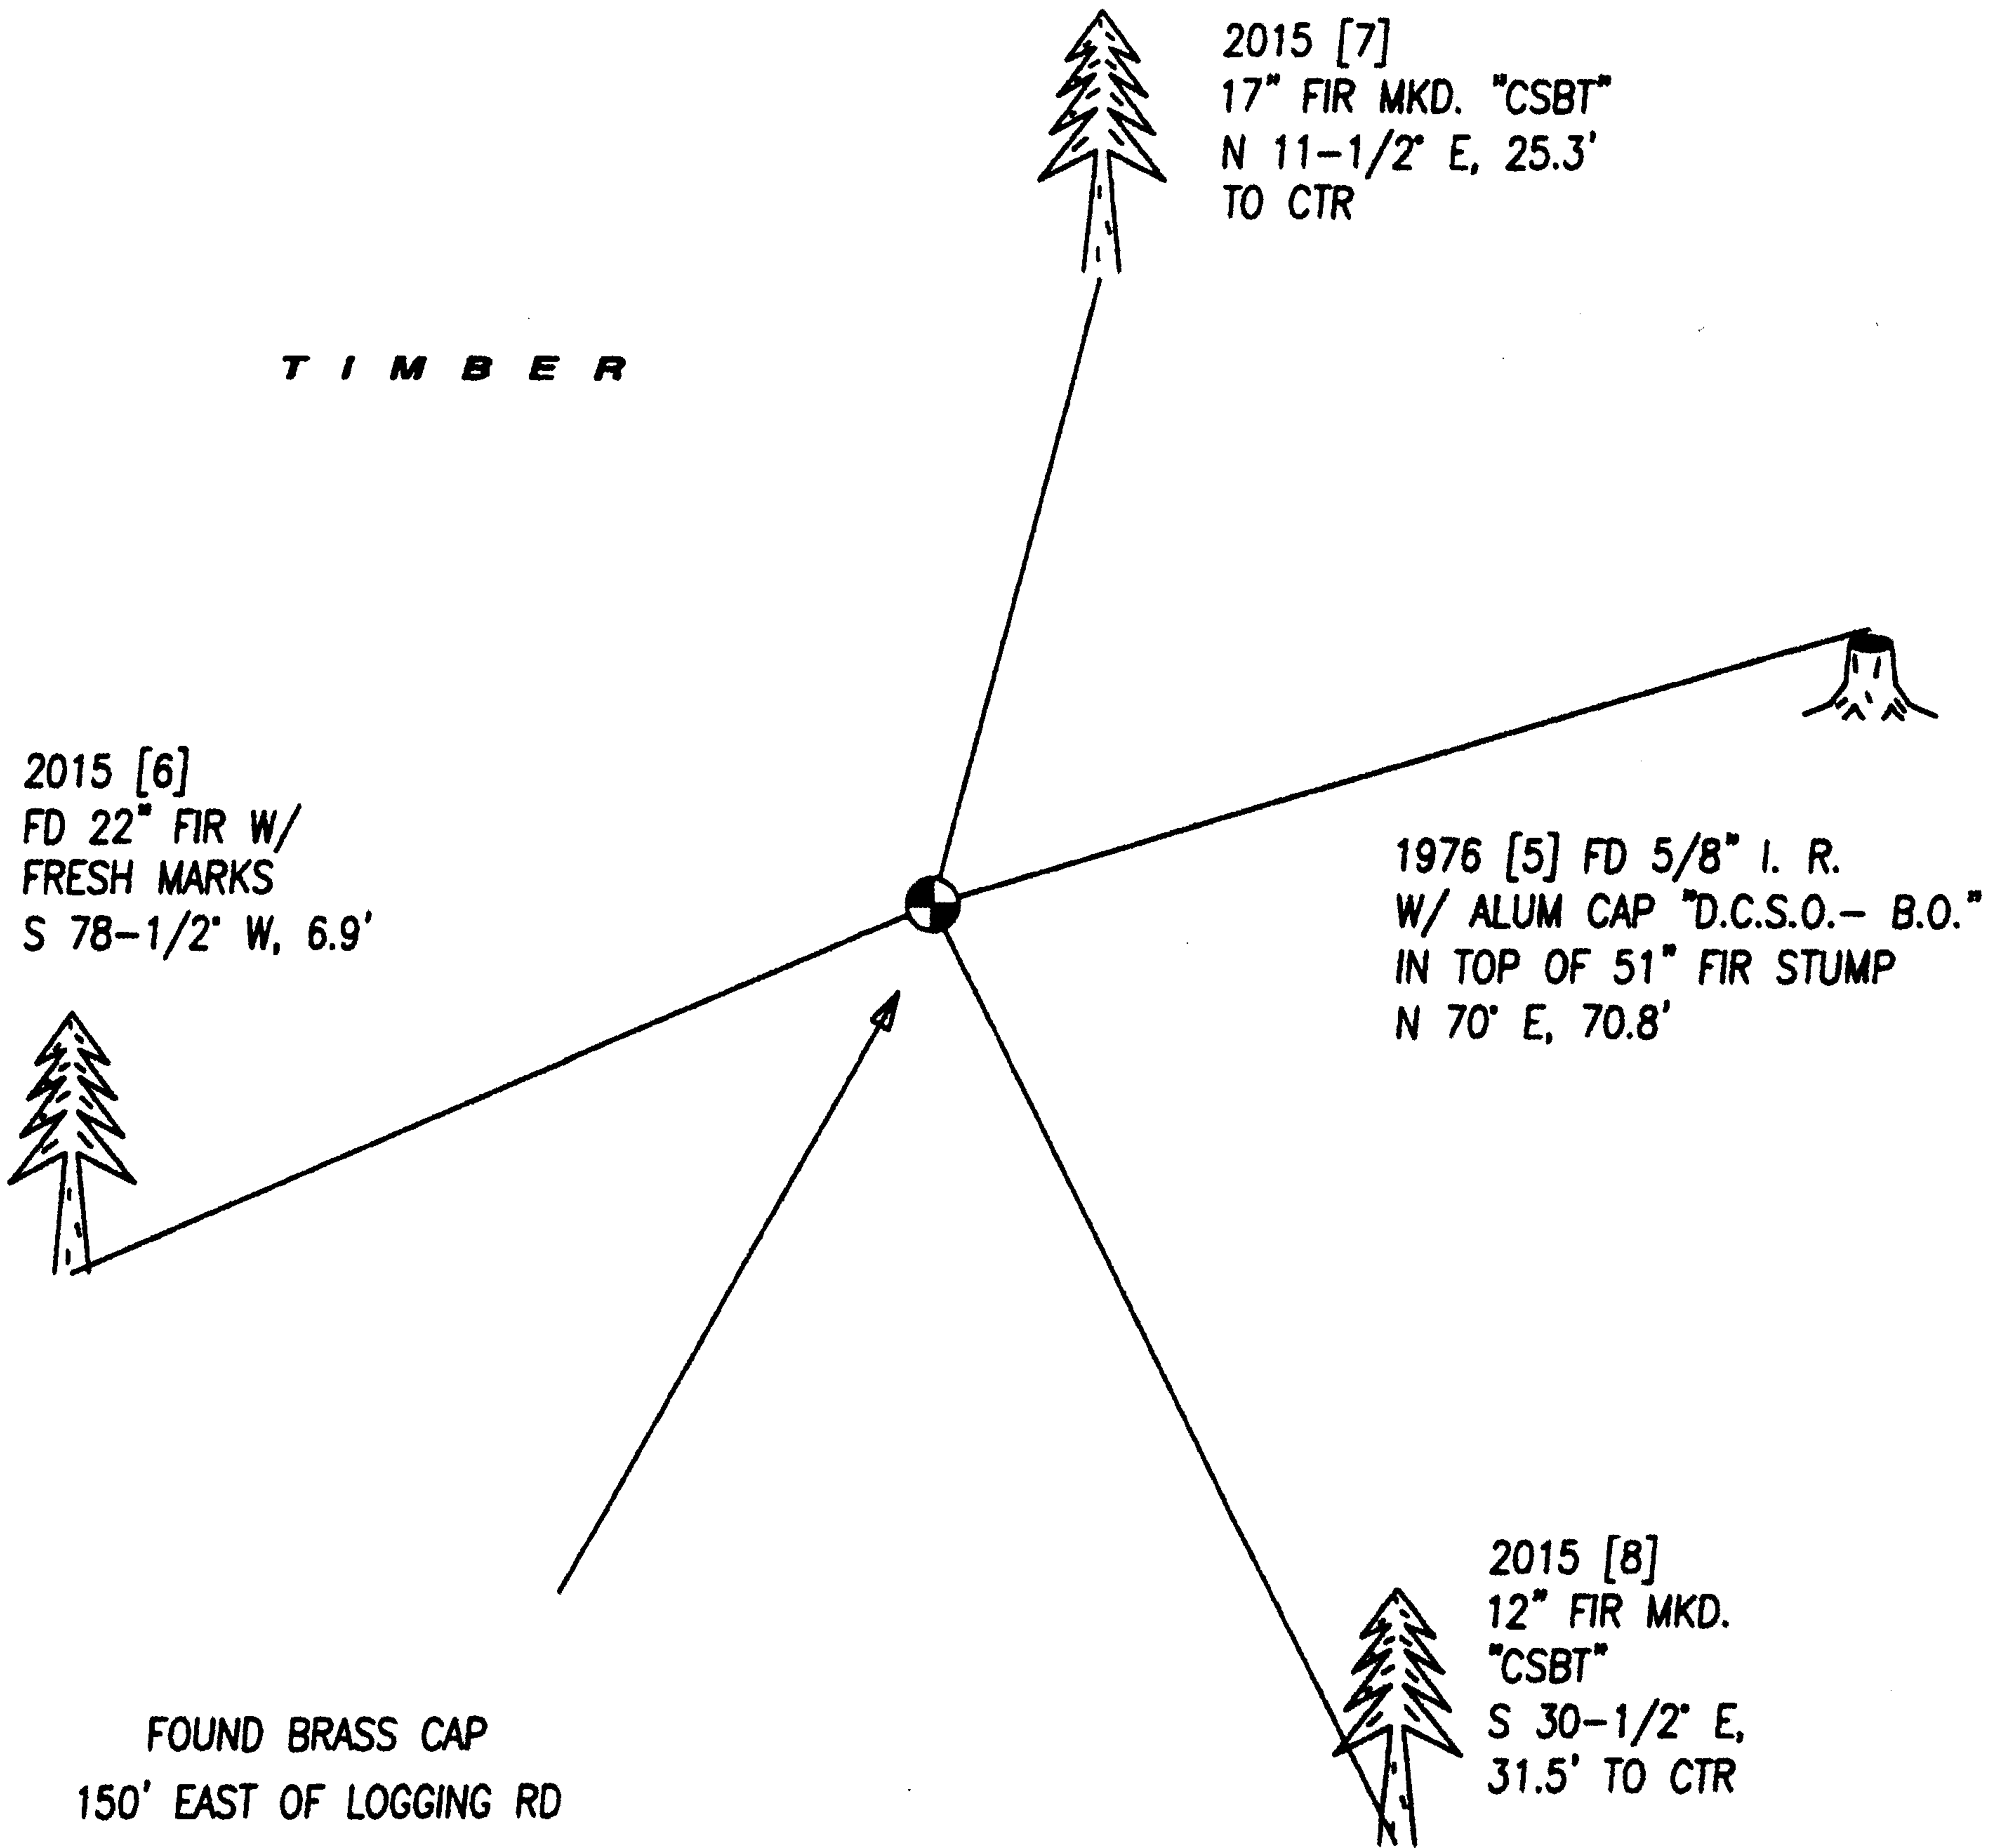

REGISTERED
PROFESSIONAL
LAND SURVEYOR

OREGON
JUNE 13, 2008
MIKEAL J. BLOMME
74387

EXPIRES DEC 31, 2015