


Index

CORNER RECORD (SEARCH)

File No. A.5-5 PROJ. NO. ELK CORNER 1/16-80
 TOWNS. 32 S RANGE 1 W R.D. TILLER COUNTY DOUGLAS GCDB# 300680
 MERID. WM FOREST UMPQUA STATE OREGON

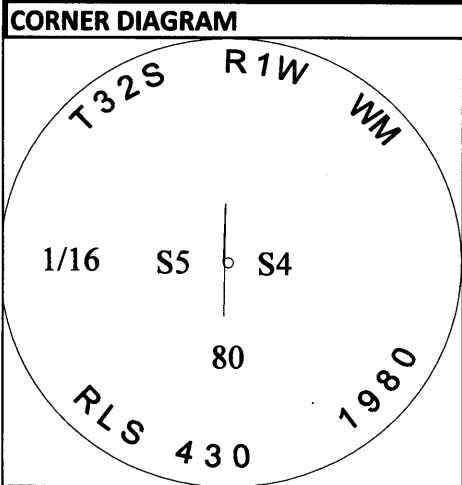

DESCRIBE CORNER MONUMENT FOUND
 FOUND 2-1/2" BRASS CAP ON 2-1/4" IRON PIPE, PROJECTING 8" ABOVE THE GROUND.

DESCRIBE BEARING TREES OR OTHER OFFICIAL ACCESSORIES FOUND

DIA	TYPE	BEARS	DIST	FACE/MARKINGS
12"	YEW	N64°45'E	11.3 FT	SCRIBE ON PART. HEALED SINGLE BLAZE
INDT	FIR STUMP	N71°30'W	33.6 FT	ROTTEN REMAINS OF STUMP, DETACHED FACE

Obj. Ident. _____
 Ident. By _____

PLANE COORDINATE POSITION DATA
 State _____ Zone _____
 North _____
 West _____
 Estab. By _____

DESCRIBE CORNER LOCATION RELATIVE TO NEAR-BY FEATURES, ALSO HOW TO REACH CORNER
 CORNER FALLS NEAR FENCE CORNER, TAKE FS ROAD 155 TO 162 ROAD, WALK 162 ROAD TO END, THEN NORTHEAST 750FT+/- TO CORNER

Signature _____ Title _____ Division _____ Headquarters _____

CORNER RECORD (PERPETUATION)

MONUMENT : DESCRIBE NEW MONUMENT SET, OR WORK DONE TO PRESERVE EXISTING MONUMENT
 BRUSH CLEARED AROUND MONUMENT AND TO BT'S
 "LAND LINE" FLAGGING TIED ON MONUMENT AND GUARD POSTS

REGISTERED PROFESSIONAL LAND SURVEYOR
John Ransom
 OREGON
 JULY 21, 1992
 JOHN C. RANSOM
 2561

ACCESSORIES : DESCRIBE NEW BT'S WITNESS OBJECTS ETC. ESTABLISHED, OR WORK DONE TO PRESERVE EXISTING EVIDENCE
 MARKED NEW BT:
 A 10" FIR BEARS, N49°15'W - 26.4 FT, MARKED: "80 1/16S5" "BT" ON A DOUBLE BLAZE

DONE BY: Jonathan Drew TITLE LSIT DATE 7/28/2014 PLS NO./AGENCY/STATE JOHN RANSOM, PLS2561
 Certified Cor. Record Prepared ? _____ Filed At: _____ DATE _____

REMARKS
 PROPERTY LINE MAINTINED WEST .5 MILES
 BASIS OF BEARING IS PLATTED BEARING(N87°45'40.1"W) USING A PROPERTY LINE POST FOUND TO THE WEST.
 MEASURMENTS BY LEICA 1103+ TOTAL STATION WITH RED LASER TO ALUMINUM NAIL SET AT SIDE CENTER.
 NEW ACCESSORIES INCLUDE A 3/4" BRASS WASHER STAMPED "LS2561" SET FLUSH IN LOWER FACE BETWEEN "B" & "T"

Index File No A.5-5 T. 32 S R. 1 W M. WM Proj No. ELK Cor. 1/16-80