


Index

CORNER RECORD (SEARCH)

File No. L-7 PROJ. NO. ELK CORNER C1/4  
 TOWNS. 31 S RANGE 1 W R.D. TILLER COUNTY DOUGLAS GCDB# 240440  
 MERID. WM FOREST UMPQUA STATE OREGON

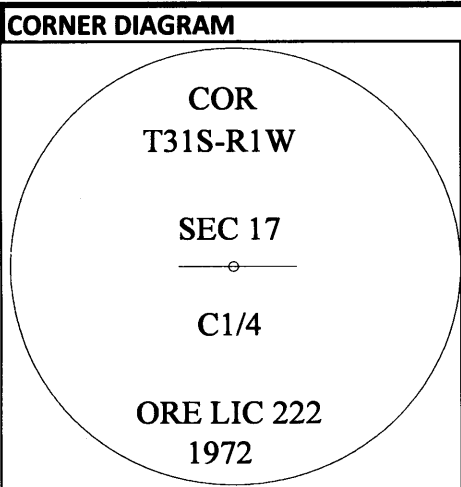

**DESCRIBE CORNER MONUMENT FOUND**  
 FOUND 3" BRASS CAP ON 2-1/2" IRON PIPE, PROJECTING 3 INCHES ABOVE CONCRETE, CONCRETE CYLINDER RESIDES IN 2-1/2 FT TALL BY 3 FT WIDE MOUND OF STONE, VERY SOLID

**DESCRIBE BEARING TREES OR OTHER OFFICIAL ACCESSORIES FOUND**

DIA	TYPE	BEARS	DIST	FACE/MARKINGS
21"	FIR	S72°E	25.7 FT	HEALED DOUBLE BLAZE
14"	OAK STUB	S52°15'W	17.4 FT	10 FT TALL, HEALED UPPER BLAZE PART. HEALED LOWER BLAZE

Obj. Ident. \_\_\_\_\_  
 Ident. By \_\_\_\_\_

Signature

**DESCRIBE CORNER LOCATION RELATIVE TO NEAR-BY FEATURES, ALSO HOW TO REACH CORNER**  
 CORNER FALLS ABOUT 75 FEET SOUTH OF PRIVATE LOGGING ROAD IN AREA OF LARGE ROCKS, TAKE 350 ROAD TO BERMED SPUR ROAD NEAR END OF 350 ROAD MAINTAINCE. FOLLOW PRIVATE ROAD EASTERLY TO WIDE PULLOFF AT SWITCHBACK, CORNER IS JUST SOUTH.

**PLANE COORDINATE POSITION DATA**  
 State \_\_\_\_\_ Zone \_\_\_\_\_  
 North \_\_\_\_\_  
 West \_\_\_\_\_  
 Estab. By \_\_\_\_\_

Signature \_\_\_\_\_ Title \_\_\_\_\_ Division \_\_\_\_\_ Headquarters \_\_\_\_\_

**CORNER RECORD (PERPETUATION)**

**MONUMENT : DESCRIBE NEW MONUMENT SET, OR WORK DONE TO PRESERVE EXISTING MONUMENT**  
 BRUSH CLEARED AROUND MONUMENT AND TO BT'S  
 "LAND LINE" FLAGGING TIED ON MONUMENT AND GUARD POSTS

REGISTERED PROFESSIONAL LAND SURVEYOR

*John Ransom*

OREGON  
 JULY 21, 1992  
 JOHN C. RANSOM  
 2561

**ACCESSORIES : DESCRIBE NEW BT'S WITNESS OBJECTS ETC. ESTABLISHED, OR WORK DONE TO PRESERVE EXISTING EVIDENCE**  
 MARKED NEW ACCESSORIES:  
 A 12" FIR BEARS, SOUTH - 33.2 FT, MARKED "C1/4S17" "BT" ON A DOUBLE BLAZE  
 A 9" FIR BEARS, N57°W - 7.5 FT, MARKED "C1/4S17" "BT" ON A DOUBLE BLAZE  
 A 6" FIR BEARS, N58°15'E - 29.1 FT, MARKED "X" "BT" ON A DOUBLE BLAZE

DONE BY: Jonathan Drew TITLE LSIT DATE 7/28/2014 PLS NO./AGENCY/STATE JOHN RANSOM, PLS2561  
 Certified Cor. Record Prepared ? \_\_\_\_\_ Filed At: \_\_\_\_\_ DATE \_\_\_\_\_

**REMARKS**  
 PROPERTY LINE MAINTINED EAST .5 MILES AND WEST .5 MILES  
 BASIS OF BEARING BEING PLATTED BEARING(N89°47'W) USING A PROPERTY LINE POST FOUND TO THE EAST.  
 MEASURMENTS BY LEICA 1103+ TOTAL STATION WITH RED LASER TO ALUMINUM NAIL SET AT SIDE CENTER.  
 NEW ACCESSORIES INCLUDE A 3/4" BRASS WASHER STAMPED "LS2561" SET FLUSH IN LOWER FACE BETWEEN "B" & "T"

Index File No L-7 T. 31 S R. 1 W M. WM Proj No. ELK Cor. C1/4

C.S. File No 65/95-17