

FILED

Date: 3/30/2017 By: DC

This survey consists of:

Map: _____

Narrative: _____

Corner Rpt: CS 65/95-19

**DOUGLAS COUNTY
SURVEYOR**

CORNER REPORT FORM

Section 31 Township 29 S Range 7 W
Douglas County Date 1/19/2017
PLSS Number 100100

CORNER DESIGNATION

SW corner Section 31 only.

- Condition Report only
- Not Found
- Renewed
- Unrecorded
- Surveyed In
- Referenced out

Previous Renewals/Surveys, etc:

Original (Corrective Resurvey) by Fred Mensch in 1924.
D.C.S. RENEWAL in 1962 by James Byron.

Monument(s) & Accessories Found: (Condition and Source)

Found a standard 1924 G.L.O. Brass capped iron pipe in good condition.
Only the 1962 D.C.S. accessories remain, to wit:
A 28" diam. broken Fir stump bears N. 69° E., 18.0 feet.
A 17" diam. Chinquapin with healed blaze bears S. 15° E., 30.4 feet

Monument Detail

Sketch

Standard 1924 G.L.O. brass cap.

Monument Set (Procedures and Description)

N/A


New Accessories

A 6" diam. Fir scribed 1/4 S31 BT bears N. 60° E., 13.1 feet.

Surveyor's Seal

Location & Comments

Compass Declination 15° East
Firm/Agency: David Edwards Land Surveying
Address: P.O. Box 361
Oakland, Oregon 97462
Party Chief: Brant Miller
Notes: _____
Witness: Eric Sprinkle

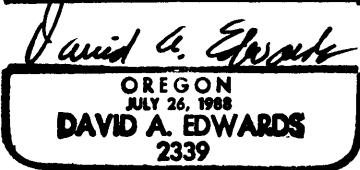

Renews 12/31/2017

C.S. File 65/95-19