

FILED

Date: 3/30/2017 By: JC

This survey consists of:

Map: _____

Narrative: _____

Corner Rpt: CS65/95-20

DOUGLAS COUNTY
SURVEYOR

CORNER REPORT FORM

Section 31 Township 29 S Range 7 W
Douglas County Date 1/19/2017
PLSS Number 100140

CORNER DESIGNATION

West 1/4 corner of Section 31 only.

- Condition Report only
- Not Found
- Renewed
- Unrecorded
- Surveyed In
- Referenced out

Previous Renewals/Surveys, etc:

Set in 1924 By G.L.O. surveyor Fred Mensch.

Monument(s) & Accessories Found: (Condition and Source)

Standard 1924 G.L.O. brass capped iron pipe in good condition.

No accessories remain.

Monument Detail

Sketch

Standard G.L.O. brass cap.

Monument Set (Procedures and Description)

N/A


New Accessories

An 11" diam. Fir bears N. 14° E., 6.7 feet. Both scribed "1/4 S31 BT"
A 12" diam. Fir bears S. 53° E., 18.0 feet.
A six foot steel post is set 2 feet North.

Surveyor's Seal

Location & Comments

Compass Declination 15° East
Firm/Agency: David Edwards Land Surveying
Address: P.O. Box 361
Oakland, Oregon 97462
Party Chief: Brant Miller
Notes: _____
Witness: Eric Sprinkle

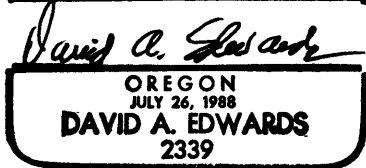

Renews 12/31/2017

C.S. File 65/95-20