

FILED

Date: 3/30/2017 By: JC

This survey consists of:

Map: \_\_\_\_\_

Narrative: \_\_\_\_\_

Corner Rpt: CS 65/95-22

DOUGLAS COUNTY  
SURVEYOR

CORNER REPORT FORM

Section 36 Township 29 S Range 8 W  
Douglas County Date 1/19/2017  
PLSS Number 700200

CORNER DESIGNATION

Corner to Sections 25  
and 36 only. ( East )

- Condition Report only
- Not Found
- Renewed
- Unrecorded
- Surveyed In
- Referenced out

Previous Renewals/Surveys, etc:

Original - Dennis Hathorn in 1855. G.L.O. survey by Mensch in 1924.  
D.C.S. renewal in 1962. B.L.M. resurvey in 1988-89 by Wayne L. Rogers.

Monument(s) & Accessories Found: (Condition and Source)

Found 1924 G.L.O. brass capped iron pipe in good condition.  
A 15" diam. Cedar with a healed blaze from the 1962 D.C.S. renewal  
bears N. 40° W., 32.3 feet.  
No other bearing trees remain.

Monument Detail

Sketch

Standard 1924 G.L.O. brass cap.

Monument Set (Procedures and Description)

N/A

New Accessories

An 8" diam. Fir scribed T29S R8W S36 BT bears S. 50° W., 20.8 feet.  
A six foot steel post is set 2 feet South.


Surveyor's Seal

Location & Comments

Compass Declination 15° East  
Firm/Agency: David Edwards Land Surveying  
Address: P.O. BOX 361  
Oakland, Oregon 97462  
Party Chief: Brant Miller  
Notes: \_\_\_\_\_  
Witness: Eric Sprinkle



*David A. Edwards*

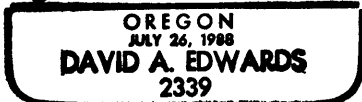

Renews 12/31/17

C.S. File 65/95-22