

FILED

Date: 3/30/2017 By: JC

This survey consists of:

Map: _____

Narrative: _____

Corner Rpt: CS 65/95-24

DOUGLAS COUNTY
SURVEYOR

CORNER REPORT FORM

Section 36 Township 29 S Range 8 W
Douglas County Date 1/23/17
PLSS Number 600100

CORNER DESIGNATION

Corner to Sections
35 and 36 only. (South)

- Condition Report only
- Not Found
- Renewed
- Unrecorded
- Surveyed In
- Referenced out

Previous Renewals/Surveys, etc:

Original G.L.O. survey by Dennis Hathorn in 1855. Found by W.H. Byars in 1882.
B.L.M. resurvey by Akin and Jelley in 1975.

Monument(s) & Accessories Found: (Condition and Source)

Found standard 1975 B.L.M. brass capped iron pipe in good condition.

All evidence of original and 1975 accessories is gone except as follows:

A 17" diam. Fir with a healed blaze and a B.L.M. tag found at it's base
bears N. 69° W., 94.8' (record= N. 59 1/4° W., 94.4 feet) = 1975 B.L.M. tree.

Monument Detail

Sketch

Standard 1975 B.L.M. brass capped iron pipe.

Monument Set (Procedures and Description)

N/A

New Accessories

A 13" diam. Fir scribed T29S R8W S36 BT bears N. 52° E., 7.75 feet.

Surveyor's Seal

Location & Comments

Compass Declination 15° East

Firm/Agency: David Edwards Land Surveying


Address: P.O. Box 361

Oakland, Oregon 97462


Party Chief: David Edwards

Notes: Brant Miller

Witness: Eric Sprinkle

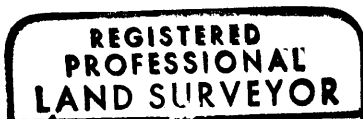

David A. Edwards

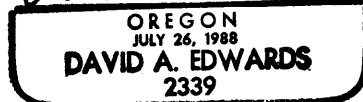

Renews 12/31/17

C.S. File 65/95-24