

FILED

Date: 3/30/2017 By: JC

This survey consists of:

Map: _____

Narrative: _____
Corner Rpt: 6565/95-25

DOUGLAS COUNTY
SURVEYOR

CORNER REPORT FORM

Section 9 Township 24 S Range 4 W
Douglas County Date 1/30/2017
PLSS Number 340540

CORNER DESIGNATION

Center 1/4 corner Section 9

- Condition Report only
- Not Found
- Renewed
- Unrecorded
- Surveyed In
- Referenced out

Previous Renewals/Surveys, etc.:

Set by B.L.M. in 1984.

Monument(s) & Accessories Found: (Condition and Source)

Standard B.L.M. brass capped iron pipe in good condition.

A 16" diam. Fir With healed blaze bears N. 52° E., 9.9 feet.

An 18" diam. Fir stump, recently cut and used for a tailholt, bears S. 70° W., 9.2 feet.

Monument Detail

Sketch

Standard B.L.M. brass capped iron pipe.

Monument Set (Procedures and Description)

N/A

New Accessories

A 19" diam. Fir scribed "C 1/4 S9 BT" bears S. 14° E., 29.46 feet to a 16d nail driven side-center at root crown.

Surveyor's Seal

Location & Comments

Compass Declination 15° East

Firm/Agency: David Edwards Land Surveying

Address: P.O. Box 361

Oakland, Oregon 97462


Party Chief: David Edwards

Notes: " "

Witness: " "



David A. Edwards

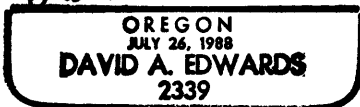

Renews 12/31/17

C.S. File 65/95-25