

FILED
Date 3/30/2017 By: JC
This survey consists of:

CORNER REPORT FORM

Section 2 Township 30 S Range 2 W
Douglas County Date 2/13/2017
PLSS Number 500640

Map: _____
Narrative: _____
Corner Rpt: CS 65/95-26
**DOUGLAS COUNTY
SURVEYOR**

CORNER DESIGNATION

1/4 corner common to Sections 2 & 3

___ Condition Report only
___ Not Found
X Renewed
___ Unrecorded
___ Surveyed In
___ Referenced out

Previous Renewals/Surveys, etc:

Original: Fred Mensch in 1908.
Douglas County Renewal in 1971 by Byron, et. al.

Monument(s) & Accessories Found: (Condition and Source)

Found 1971 D.C.S. Brass Capped iron pipe in good condition.
Orig. B.T., a 7" diam. Yew with axed face bears N. 34° E., 6.6 feet.
The original Hemlock in Section 3 is a blowdown.
1971 D.C.S. B.T., a 22" diam. high stumped Fir bears N. 63° E., 10.8 feet.
Scribing visible on partially healed blaze.

Monument Detail

Sketch

Standard 1970's D.C.S. brass capped iron pipe.

Monument Set (Procedures and Description)

N/A


New Accessories

A 5" diam. Fir scribed "1/4 S3 BT" bears S. 33° W., 11.0 feet.
A six foot steel post is set 2 feet North.


Surveyor's Seal

Location & Comments

Compass Declination 15° East
Firm/Agency: David Edwards Land Surveying
Address: P.O. Box 361
Oakland, Oregon 97462
Party Chief: Brant Miller
Notes: _____
Witness: Eric Sprinkle

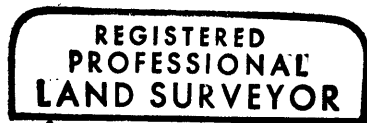

David A. Edwards

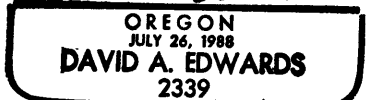

Renews 12/31/17

C.S. File 65/95-26