

OREGON CORNER RESTORATION FORM

SECTION 3

TOWNSHIP 23 S.

RANGE 6 W

COUNTY DOUGLAS

DATE 2/17/2017

TRACT J22-6-34

CORNER DESIGNATION:

T 23 S R 6 W

1/4 S3

POINT IDENTIFIER 440700

- CONDITION REPORT ONLY
- NOT FOUND
- RENEWED
- UNRECORDED
- SURVEYED IN
- REFERENCED OUT

PREVIOUS RENEWALS/SURVEYS, ETC:


BLM RESURVEY BY DOUGLAS COUNTY RECORDS VOL. 30 PAGE 12627, BRANCH 1992 SURVEYS M115 - 26 & M115 - 23

ACCESSORIES FOUND: (CONDITION AND SOURCE)


45" DOUG FIR BEARS S73°W 43.4FT. (RECORD FROM BLM FIELD NOTES VOL. 30 PAGE 12627 S72°W 43.56 FT.)

HEALED FACE AND TAG

MONUMENT DETAIL:

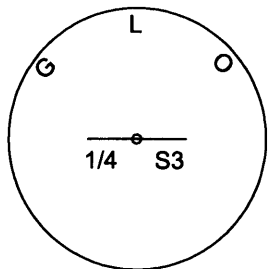

SKETCH:
(NOT TO SCALE)

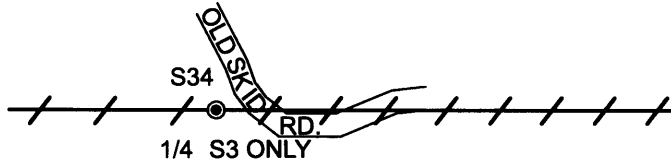

LEGEND:

- LINES BLAZED, PAINTED AND TAGGED
- FND 1943 GLO BRASS CAP

FILED

Date: 3-30-2017 By: JC

This survey consists of:

Map: _____

Narrative: _____

Corner Rpt: CS 65/95-28

MONUMENT:

FOUND 1943 GENERAL LAND OFFICE BRASS CAP FOR THE 1/4 CORNER FOR SECTION 3 ONLY

**DOUGLAS COUNTY
SURVEYOR**

NEW ACCESSORIES:

14" DOUG FIR BEARS S21 1/4°E 4.2 FT WE SCRIBE T23S R6W 1/4 S3 BT AND TAG TREE

BEARING BASIS: ASSUMED FROM BRANCH

1992 SURVEY M115 - 23

FIRM/AGENCY: LONE ROCK TIMBER MANAGEMENT CO.

ADDRESS: P.O. BOX 1127

ROSEBURG, OR 97470

PARTY CHIEF: KEN W. HOFFINE

NOTES: GARY ANGIOLET

WITNESS: GARY ANGIOLET

LOCATION & COMMENTS:

THE NORTH 1/4 CORNER FOR SECTION 3 LIES APPROX.

35 FEET WEST OF OLD SKID ROAD. THERE ARE A NUMBER

OF TREES THAT HAVE BLOWN OVER NEAR THE CORNER.

WE PUT METAL U-POST APPROX. 0.5 FEET NORTH OF

CORNER.

REGISTERED
PROFESSIONAL
LAND SURVEYOR

Ken W Hoffine

OREGON
JULY 16, 1987
KEN W. HOFFINE
PLS 2291

C.S. File No 65/95-28

EXPIRES 6-30-17