

OREGON CORNER RESTORATION FORM

SECTION 6 TOWNSHIP 29 S. RANGE 3 W
COUNTY DOUGLAS DATE 2/21/2017 TRACT BMH 7215

CORNER DESIGNATION:

T 29 S R 3 W
1/4 S6
S7

POINT IDENTIFIER 140600

- CONDITION REPORT ONLY
- NOT FOUND
- RENEWED
- UNRECORDED
- SURVEYED IN
- REFERENCED OUT

FILED
Date: 6/27/2017 By: X
This survey consists of:
Map: _____
Narrative: _____
Corner Rpt: CS 65/95-30

PREVIOUS RENEWALS/SURVEYS, ETC:

BLM RESURVEY BY JELLEY AND ROGERS DOUGLAS COUNTY RECORDS VOL. 43 PAGE 16900

**DOUGLAS COUNTY
SURVEYOR**

ACCESSORIES FOUND: (CONDITION AND SOURCE)



21" CEDAR BEARS N53 1/2°E 27.2 FT. (RECORD FROM BLM FIELD NOTES VOL. PAGE 16900 N54 1/2 °E 26.4 FT.)

HEALED FACE AND TAG

MADRONE ROOT HOLE BEARS S84°W 29.3 FT. (RECORD FROM BLM FIELD NOTES VOL. PAGE 16900 S84°W 29.04 FT.)

MONUMENT DETAIL:

SKETCH:
(NOT TO SCALE)

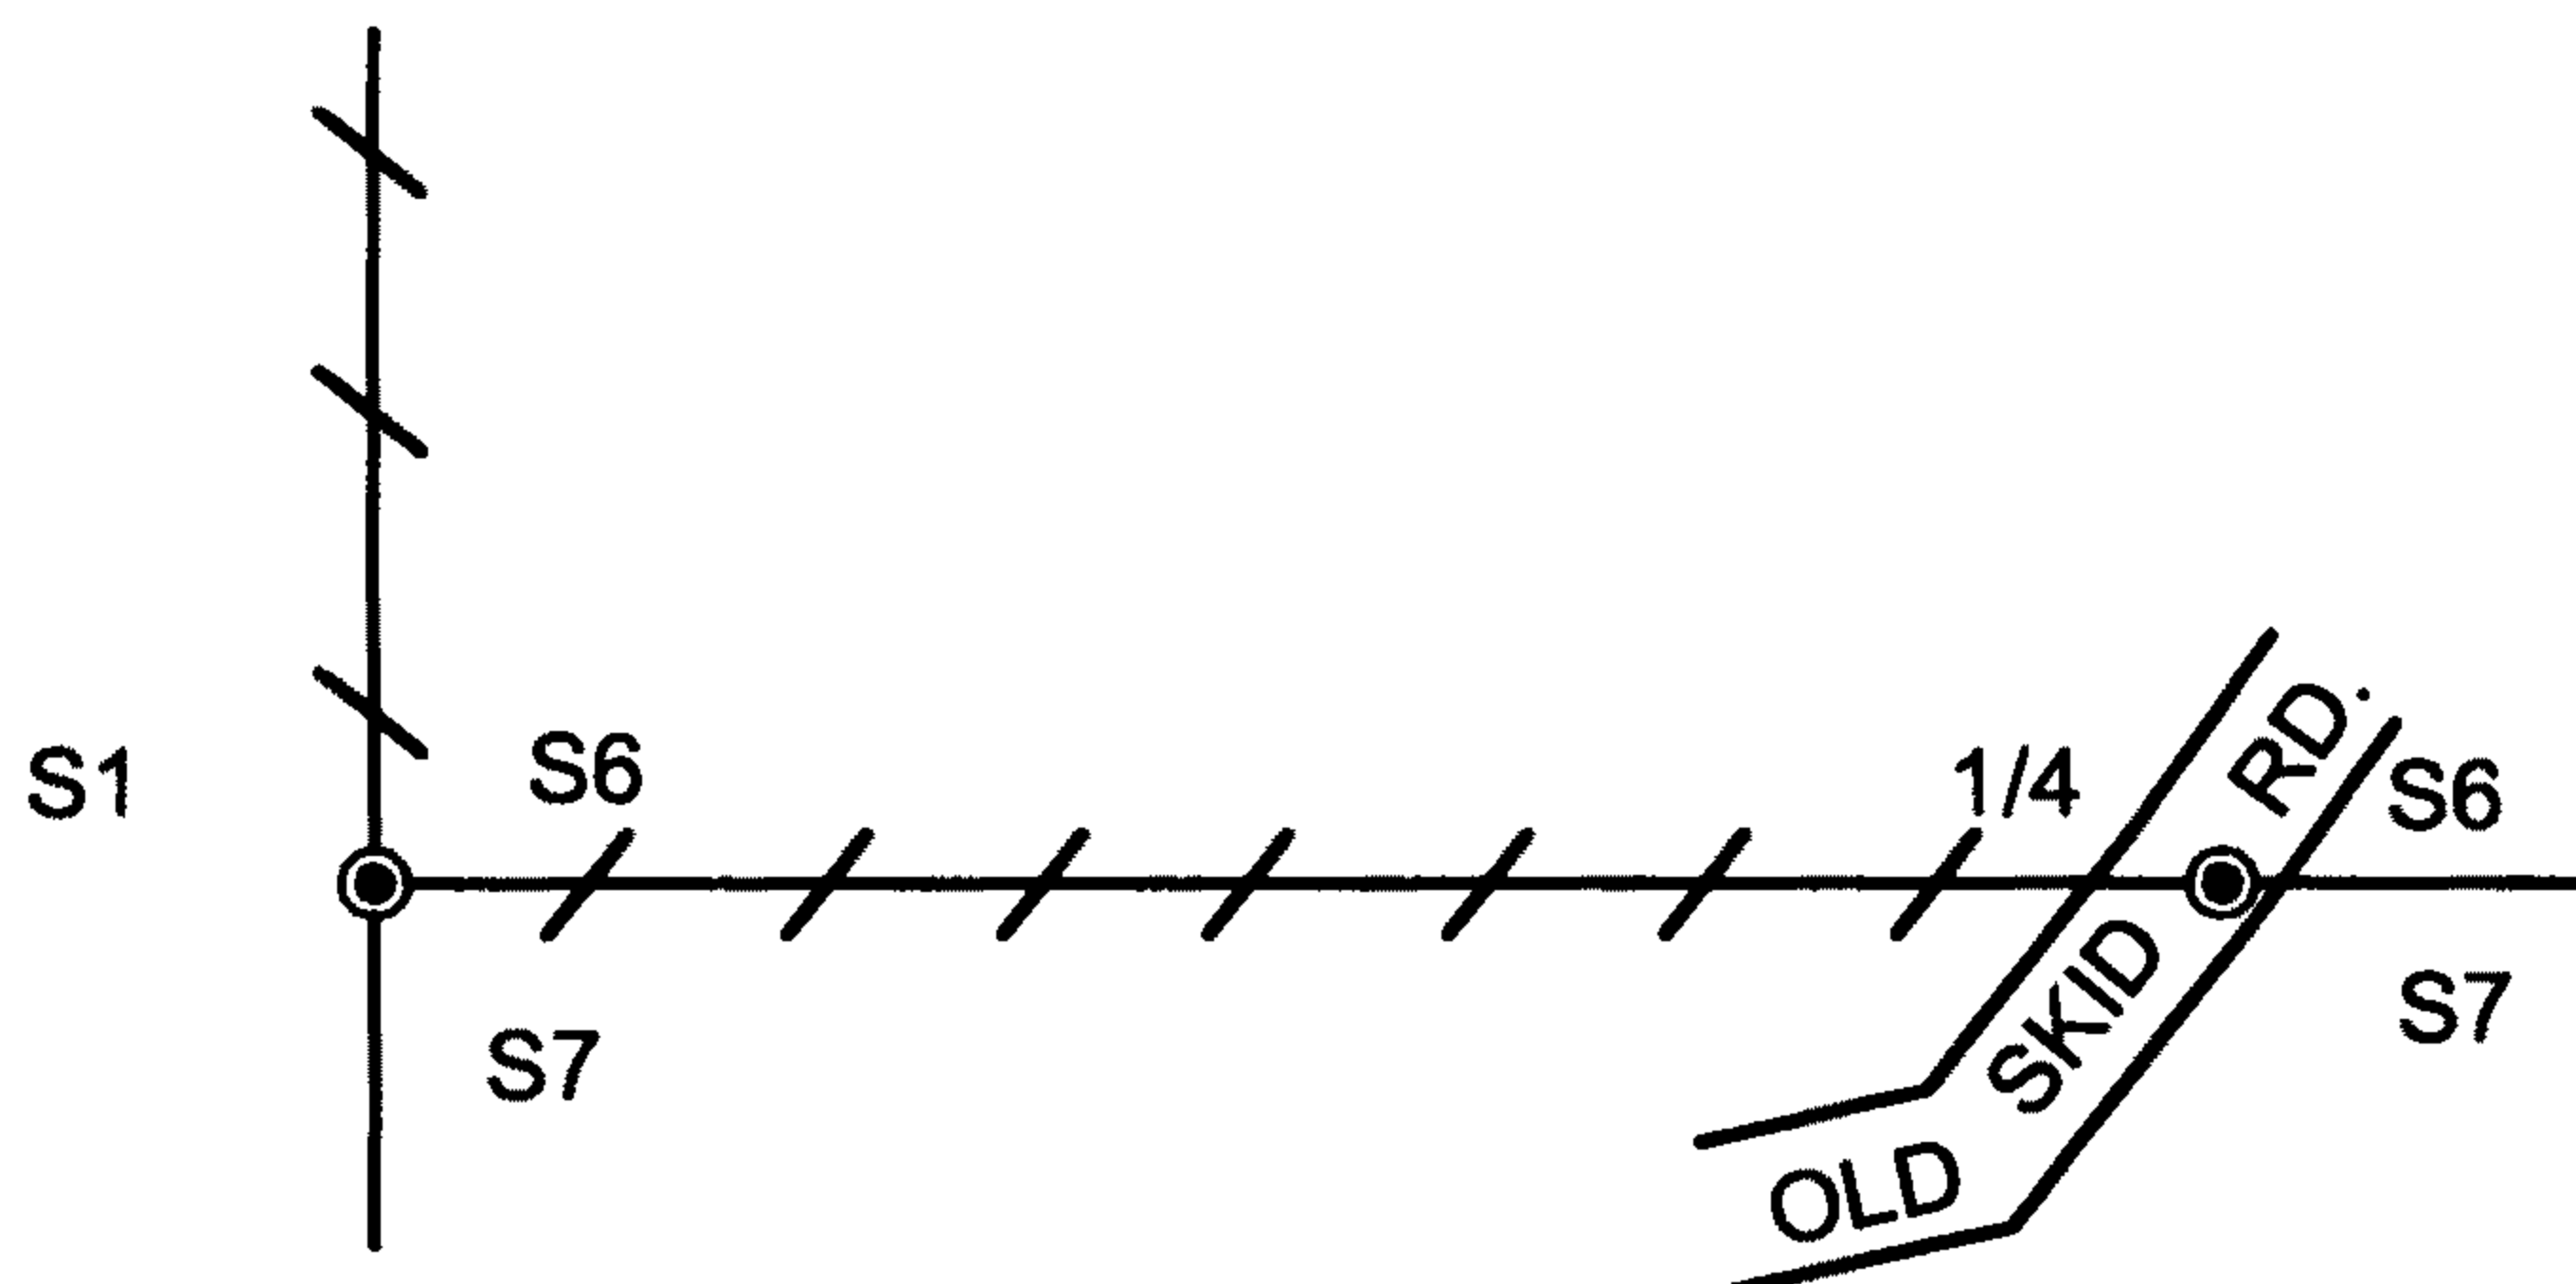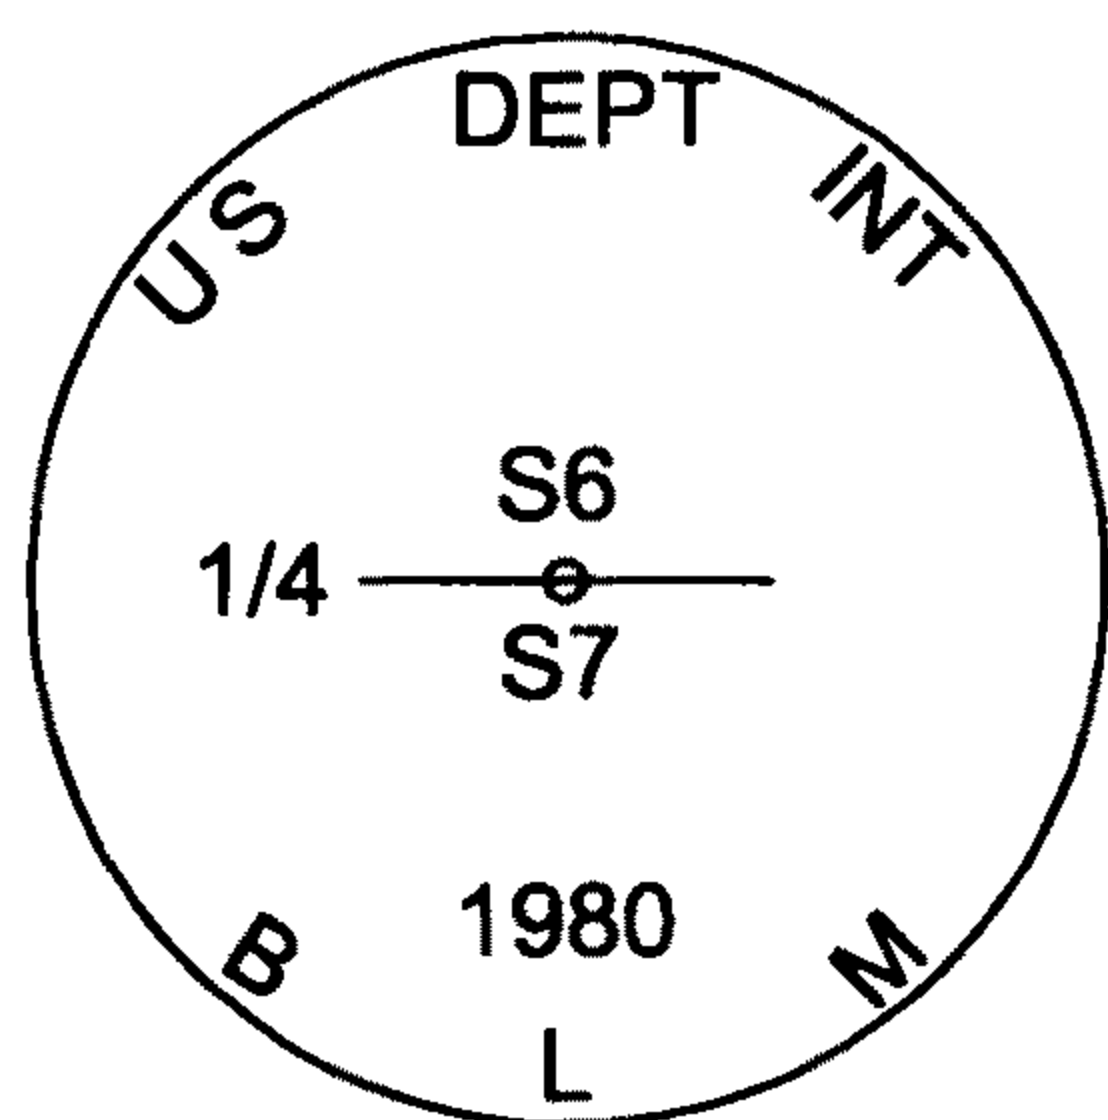

LEGEND:

- LINES BLAZED, PAINTED AND TAGGED
- FND 1997 BLM BRASS CAP

MONUMENT:

FOUND 1980 BUREAU OF LAND MANAGEMENT BRASS CAP

NEW ACCESSORIES:

14" DOUG FIR BEARS S21°E 15.9 FT. WE SCRIBE T29S R3W 1/4 S7 BT AND TAG TREE

8" DOUG FIR BEARS S33 3/4°W 23.5 FT. WE SCRIBE T29S R3W 1/4 S7 BT AND TAG TREE

17" DOUG FIR BEARS N83 3/4°W 27.2 FT. WE SCRIBE T29S R3W 1/4 S6 BT AND TAG TREE

LOCATION & COMMENTS:

WE RAN A LOOPED RANDOM TRAVERSE FROM THE S1/4 TO THE SOUTHWEST SECTION CORNER OF SECTION 6, TO MARK PROPERTY LINE. WE FIND THE 1980 BLM BRASS CAP ON EAST EDGE OF OLD SKID ROAD, 0.4 FEET ABOVE GROUND, AND PUT METAL U-POST APPROX. 1.0 FEET NORTH OF CORNER.

BEARING BASIS: ASSUMED FROM BLM FIELD

NOTES VOL. 43 PAGE 16900

FIRM/AGENCY: LONE ROCK TIMBER MANAGEMENT CO.

ADDRESS: P.O. BOX 1127
ROSEBURG, OR 97470

PARTY CHIEF: KEN W. HOFFINE

NOTES: GARY ANGIOLET

WITNESS: G. ANGIOLET

REGISTERED
PROFESSIONAL
LAND SURVEYOR

Ken W Hoffine
OREGON
JULY 16, 1987
KEN W. HOFFINE
PLS 2291

C.S. FILE 65/95-30

EXPIRES 6-30-17