

OREGON CORNER RESTORATION FORM

SECTION 36

TOWNSHIP 29 S.

RANGE 5 W

COUNTY DOUGLAS

DATE 2/23/2017

TRACT BRYANT

POINT IDENTIFIER 600100

CORNER DESIGNATION:

T 29 S R 5 W
 S35 | S36
 T 30 S R 5 W
 S2

_____ CONDITION REPORT ONLY
 _____ NOT FOUND
 _____ X RENEWED
 _____ UNRECORDED
 _____ SURVEYED IN
 _____ REFERENCED OUT

FILED
 Date: 6/27/2017 By: JC
 This survey consists of:
 Map: _____
 Narrative: _____
 Corner Rep: CS06/95-31
DOUGLAS COUNTY
SURVEYOR

PREVIOUS RENEWALS/SURVEYS, ETC:

LRT EDWARDS MAP M149-60, BLM LINE NOTES PAGE 15514


ACCESSORIES FOUND: (CONDITION AND SOURCE)

27" DOUGLAS FIR BEARS N85°E 28.4 FT. (RECORD FROM BLM FIELD NOTES PAGE 15514 N87 1/2°W 27.72 FT.)


HEALED FACE AND TAG

RECORD BEARING TREE AT N86°E 29.04 FT. IS BLOWN OVER AND UPROOTED.

MONUMENT DETAIL:

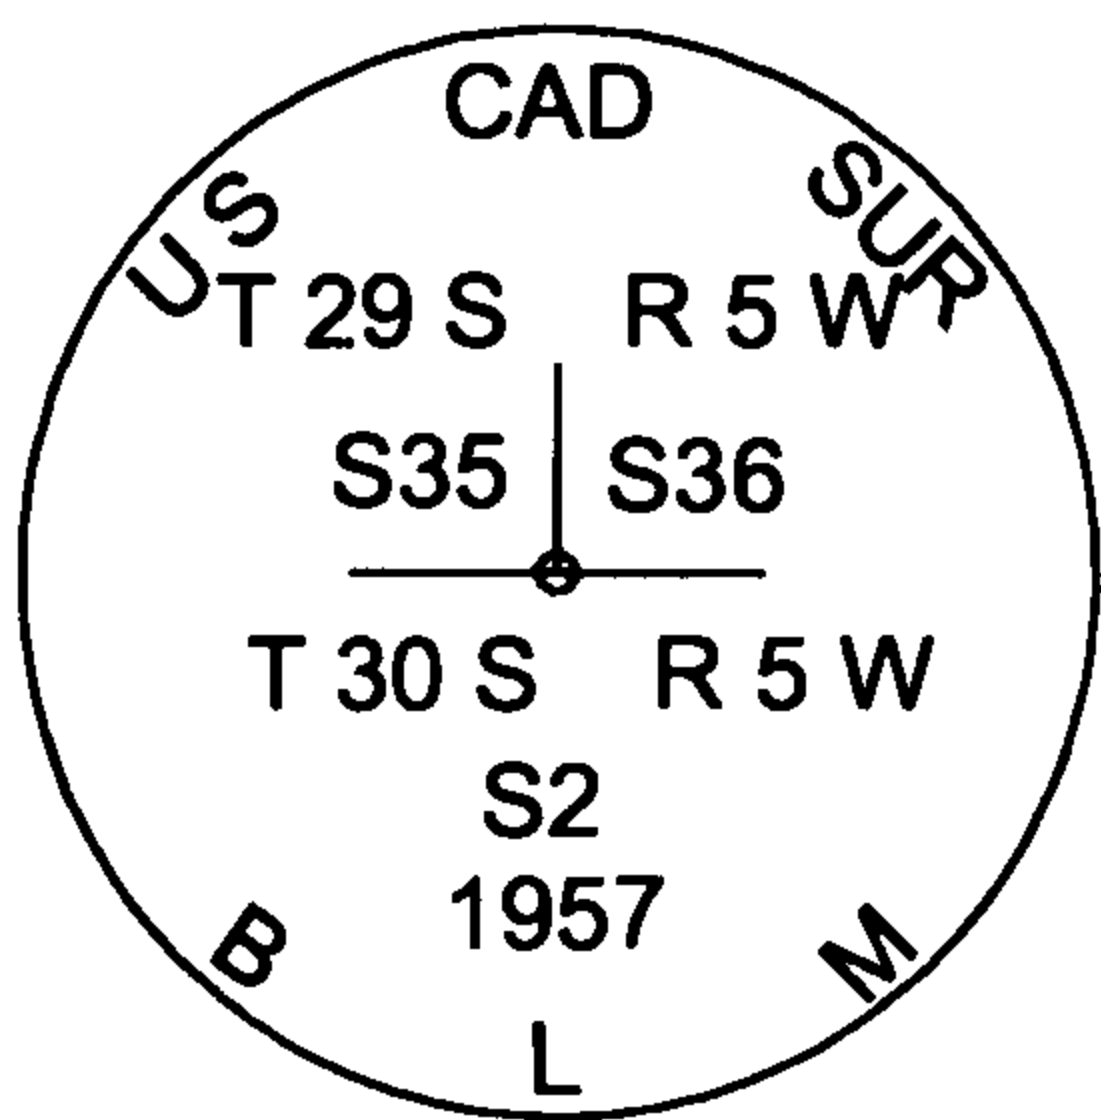

SKETCH:
(NOT TO SCALE)

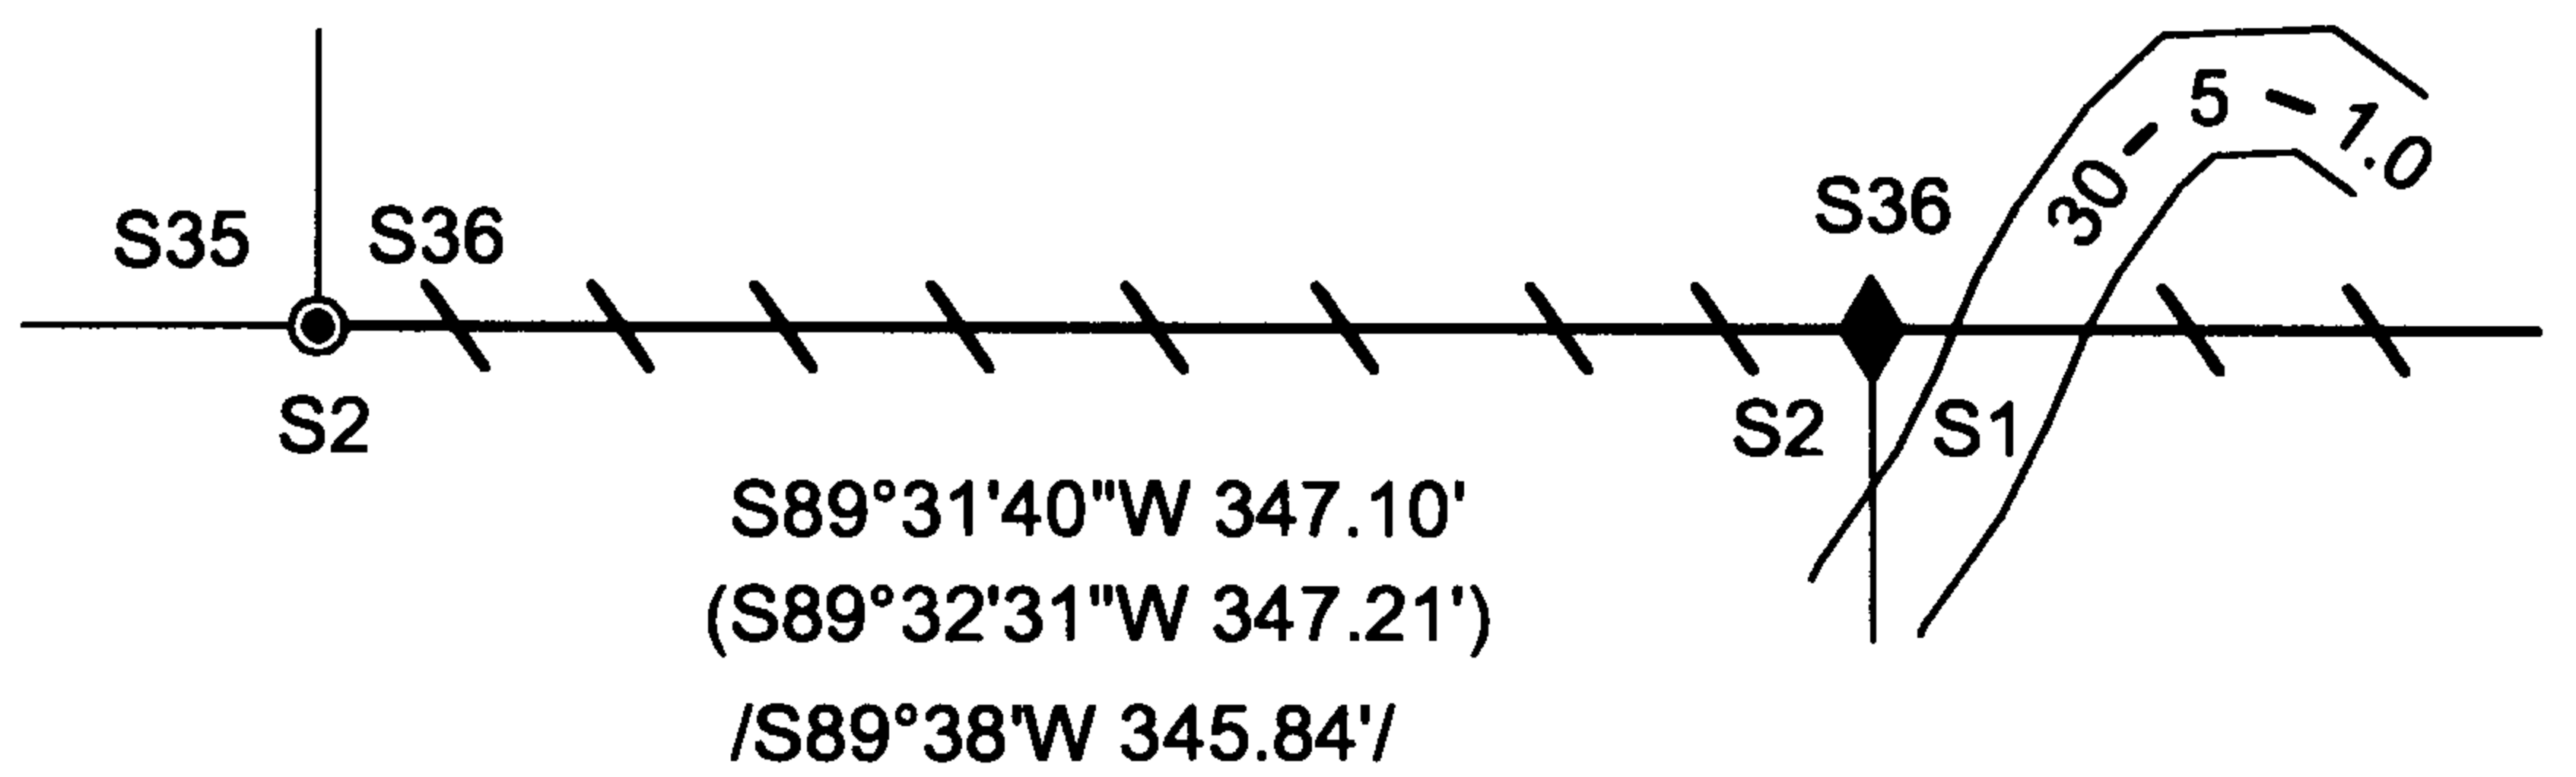

LEGEND:

- ◆ FND 1969 BLM BRASS CAP
- FND 1957 BLM BRASS CAP
- () RECORD FROM LRT - EDWARDS MAP M 149 - 60
- // RECORD FROM BLM NOTES PG. 15513 -14
- / — LINES FLAGGED, TAGGED, BLAZED, AND PAINTED

MONUMENT:

FOUND 1957 BUREAU OF LAND MANAGEMENT BRASS CAP

NEW ACCESSORIES:

35" DOUG FIR BEARS N69 3/4°W 49.6 FT. WE SCRIBE T29S R5W S35 BT AND TAG TREE

BEARING BASIS: FROM MAP M 149 60 N1/4
TO NWSC OF SECTION 1 T30S R5W
FIRM/AGENCY: LONE ROCK TIMBER MANAGEMENT CO.
ADDRESS: P.O. BOX 1127
ROSEBURG, OR 97470
PARTY CHIEF: KEN W. HOFFINE
NOTES: G. ANGIOLET
WITNESS: IGNACIO ROMAN

LOCATION & COMMENTS:

FOUND 1957 BLM BRASS CAP AT GROUND LEVEL WITH A
METAL FENCE POST APPROX. 1.0 FEET NORTH OF CORNER.
CORNER LAYS APPROX 400 FEET WEST OF 30-5-1.0 ROAD AND
S89°31'40"W 347.1 FEET FROM THE CLOSING CORNER FOR
SECTIONS 1 AND 2 T30S R5W

REGISTERED
**PROFESSIONAL
 LAND SURVEYOR**

Ken W Hoffine
 OREGON
 JULY 16, 1987
KEN W. HOFFINE
 PLS 2291

C.S. FILE 65/95-31

EXPIRES 6-30-17