

FILED

Date: 6/27/2017 By: SC

This survey consists of:

Map: _____

Narrative: _____

Corner Rpt: CS 65/95-33

DOUGLAS COUNTY
SURVEYOR

CORNER REPORT FORM

Section 22 Township 25S Range 3W

Douglas County

Date 4-2017

PLSS Number

460340

CORNER DESIGNATION

CE V10 522

<input checked="" type="checkbox"/>
<input type="checkbox"/>
<input type="checkbox"/>
Condition Report only
 Not Found
 Renewed
 Unrecorded
 Surveyed In
 Referenced out

Previous Renewals/Surveys, etc:

R. Quimby M120-17

Monument(s) & Accessories Found: (Condition and Source)

5/8" IR with PLASTIC CAP MARKED A SURVEYING

12" D. FIR N2 1/2° W 32.1 FEET GOOD SCAR

14" D. FIR S39 1/2° W 37.6 FT. GOOD SCAR

Monument Detail

Sketch

Monument Set (Procedures and Description)

New Accessories

Surveyor's Seal

Location & Comments

CORNER IS
APPROX 200' North
OF RD 8400

Compass Declination 15° E

Firm/Agency: i.e. Engineering, Inc.



Address:

809 SE Pine St., Roseburg, OR 97470

Party Chief: N. Fromhart

Notes:

Witness: R. OLSEN

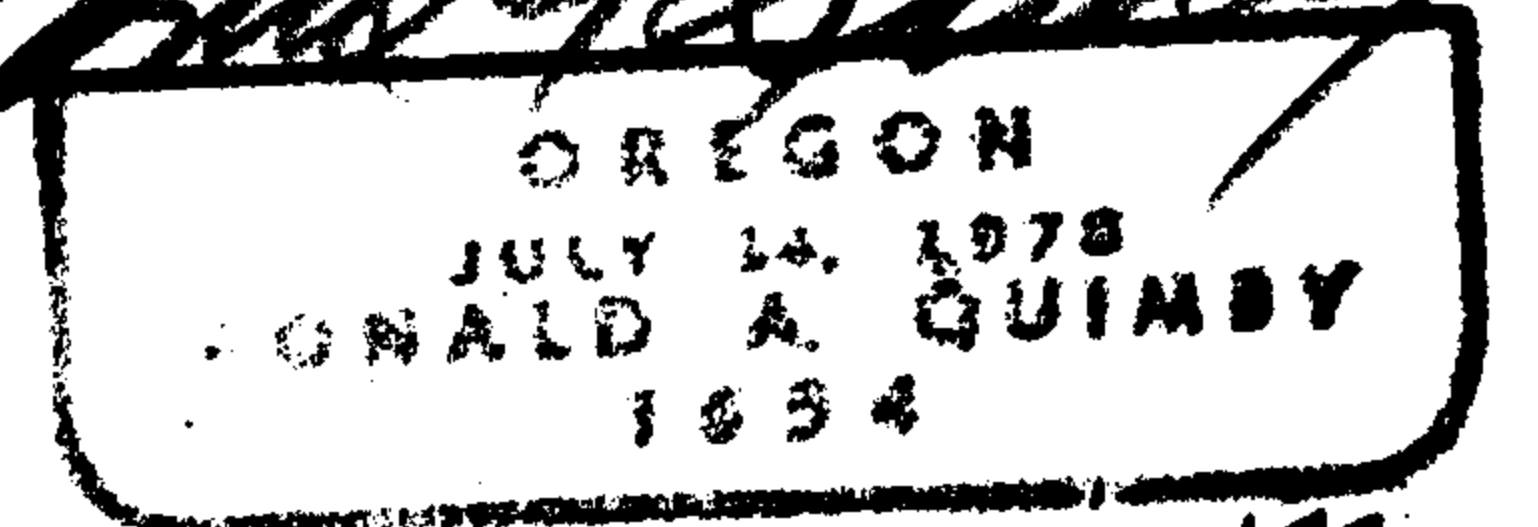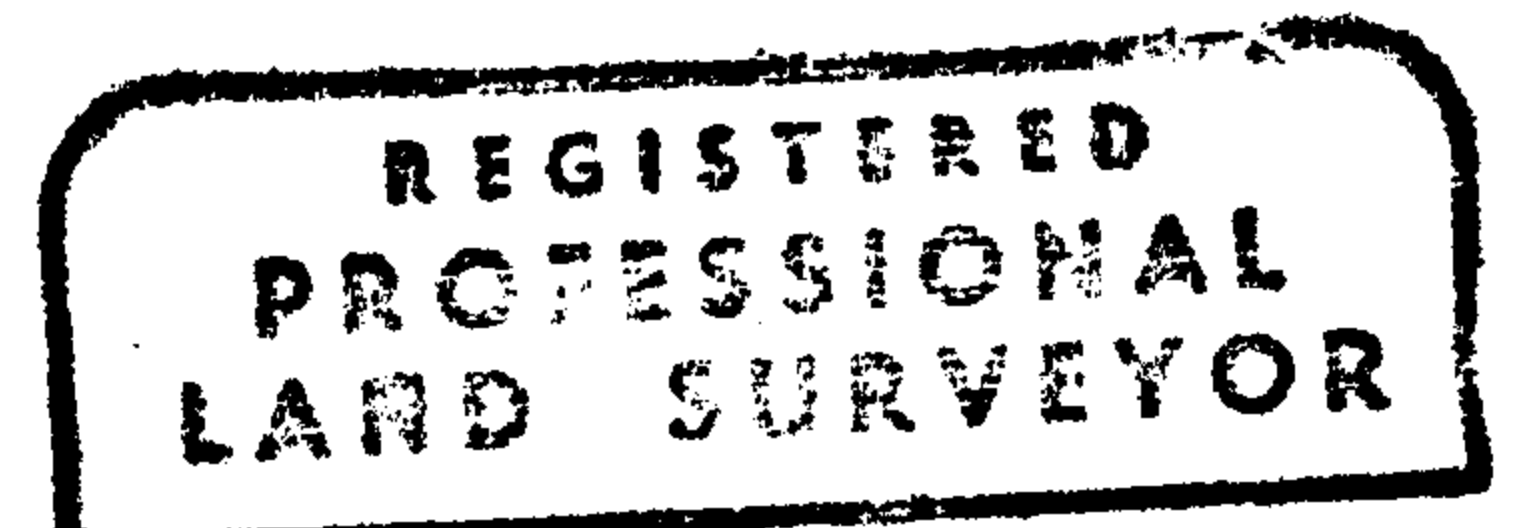

EXP 12-31-18

C.S. File 65/95-33