

FILED

Date: 6/27/2017 By: XC

This survey consists of:

Map: \_\_\_\_\_

Narrative: \_\_\_\_\_

Corner Rpt: CS 65/95-34

DOUGLAS COUNTY  
SURVEYOR

CORNER REPORT FORM

Section 22 Township 25S Range 8W

Douglas County Date 4-2017

PLSS Number

460300

CORNER DESIGNATION

E 1/16 22/27



Condition Report only  
 Not Found  
 Renewed  
 Unrecorded  
 Surveyed In  
 Referenced out

Previous Renewals/Surveys, etc:

Templin 1970 CS File 55/177


Monument(s) & Accessories Found: (Condition and Source)

1 1/2" I.P with BRASS CAP

A 34" FIR STUMP S39°W 16 1/2 FT.

Monument Detail

Sketch

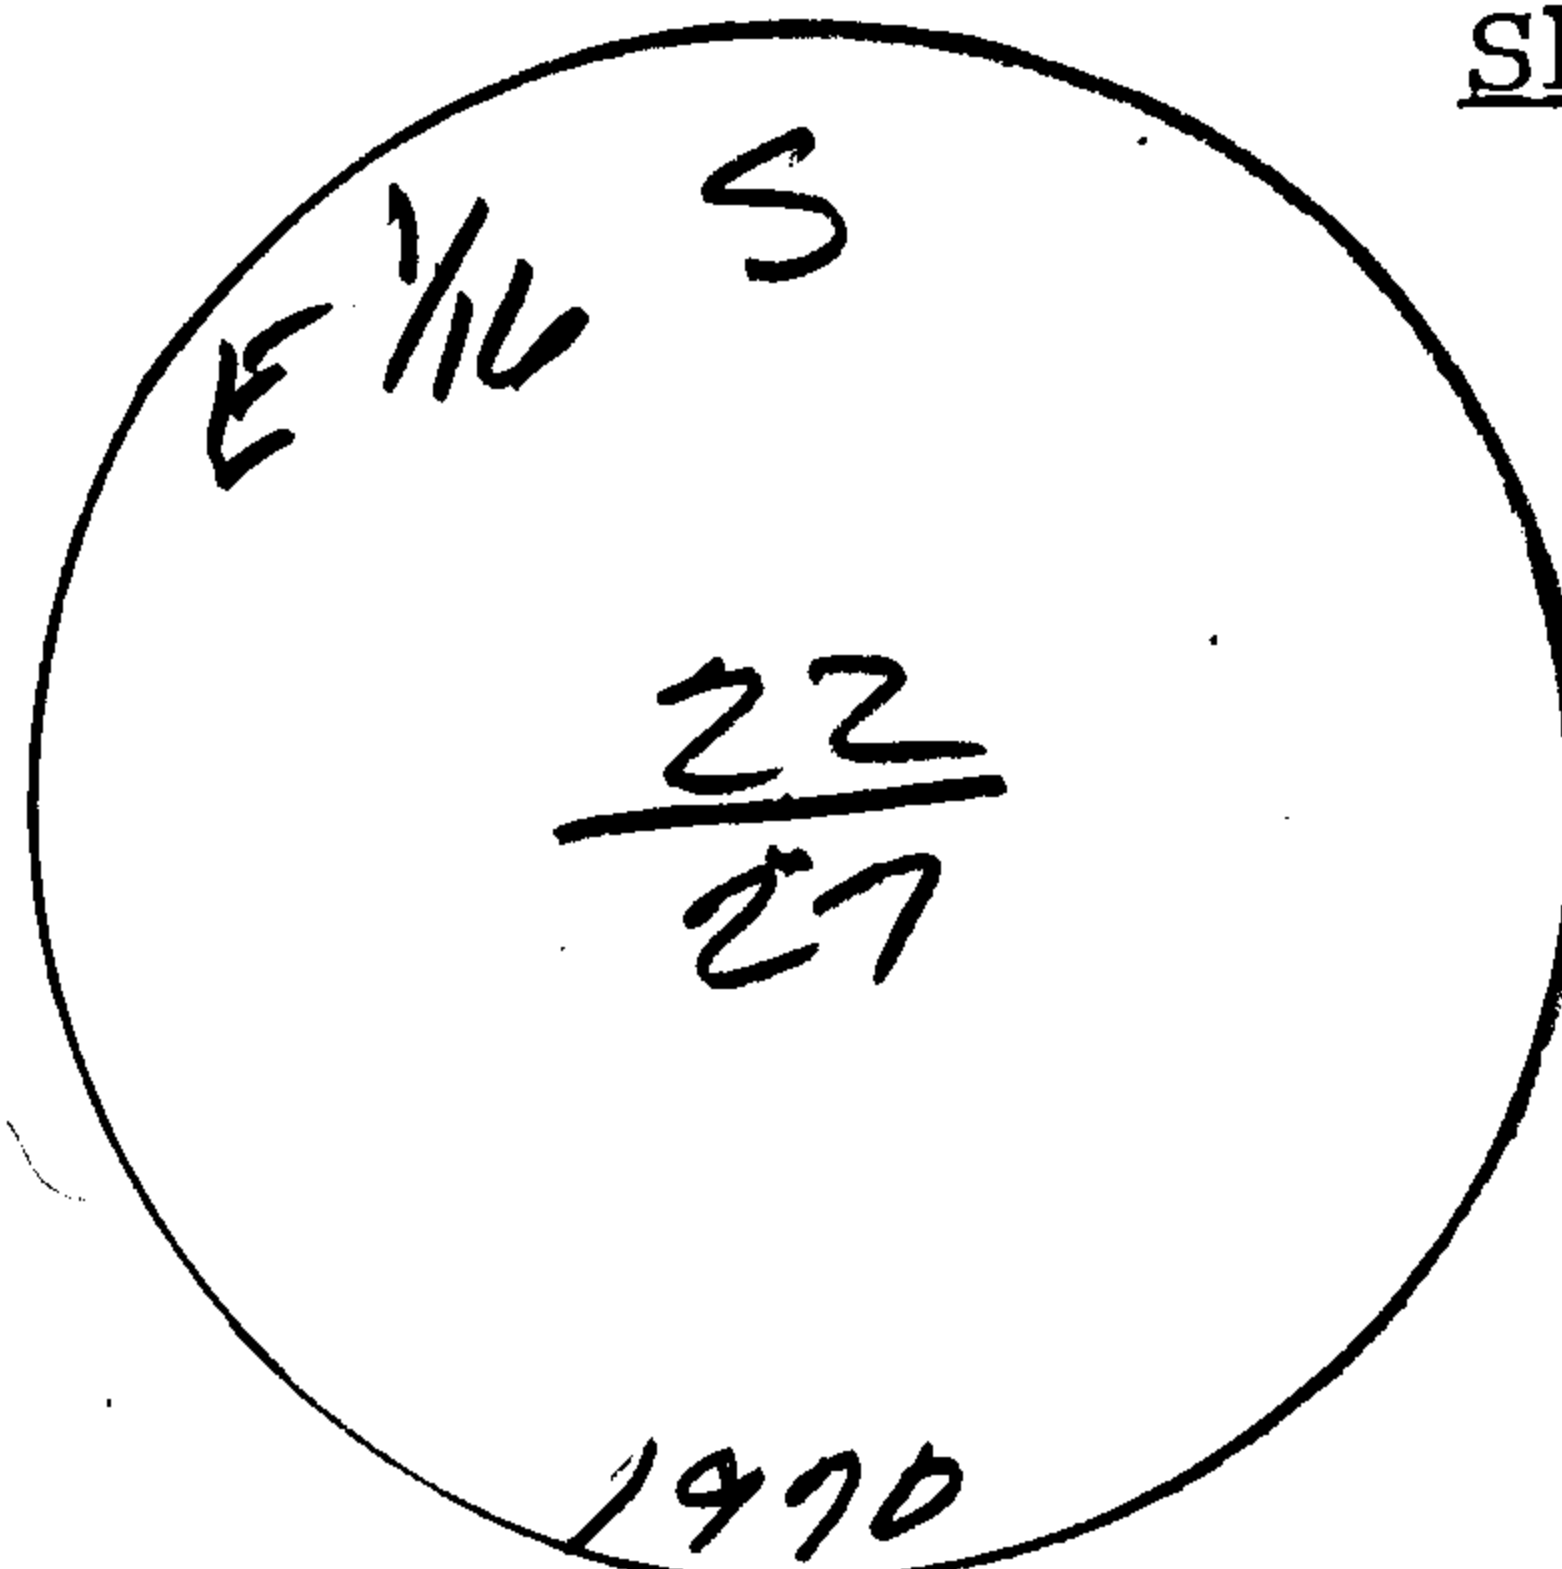

Monument Set (Procedures and Description)

12" Hemlock N70W 13.2 FT Scribed E 1/16 S22 RT  
14" Hemlock S38E 15.3 FT Scribed E 1/16 S27 BT

New Accessories

Surveyor's Seal

Location & Comments

Compass Declination N 15 1/2° E

Firm/Agency: i.e. Engineering, Inc.



Address:

809 SE Pine St., Roseburg, OR 97470

Party Chief: N From Dahl

Notes:

Witness: R. OLSEN

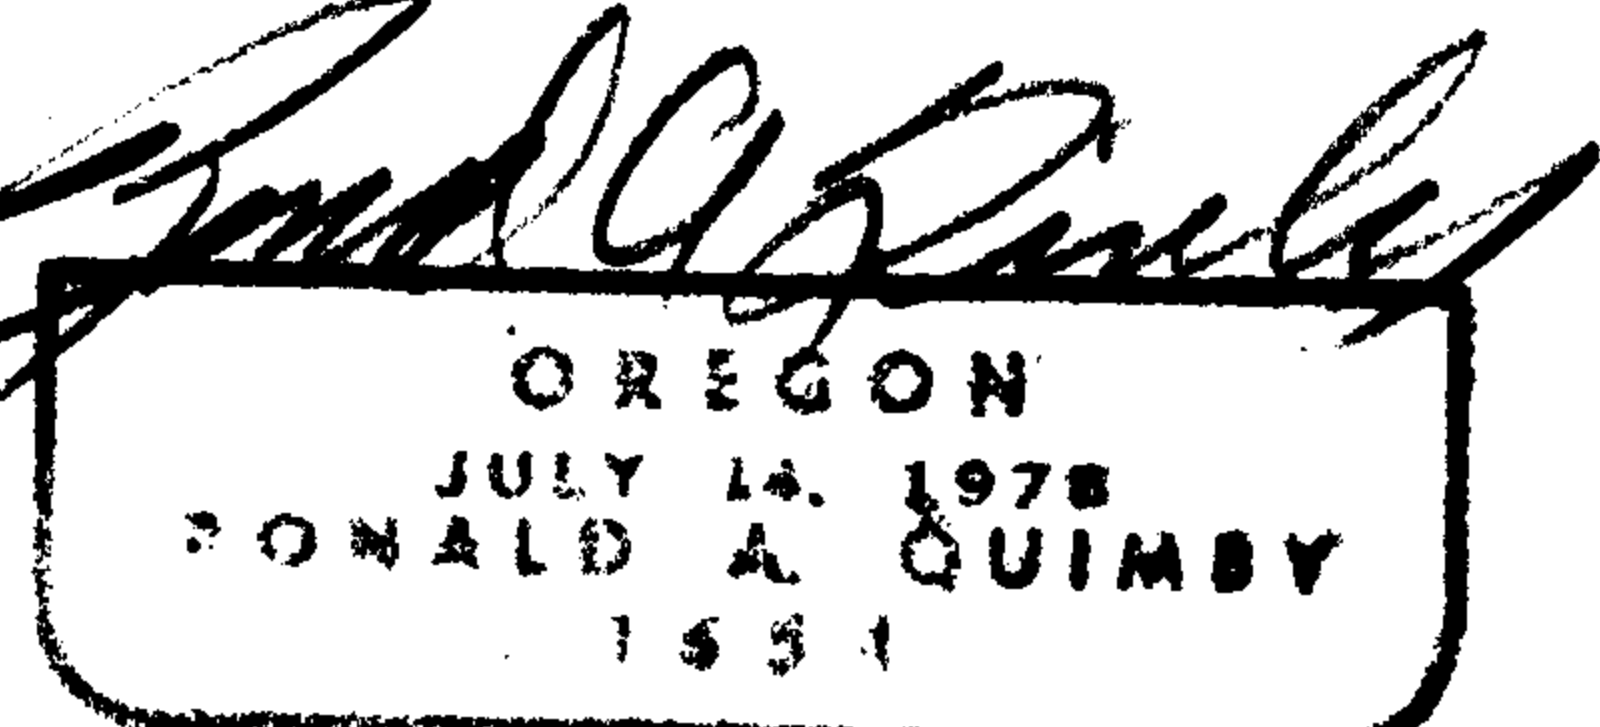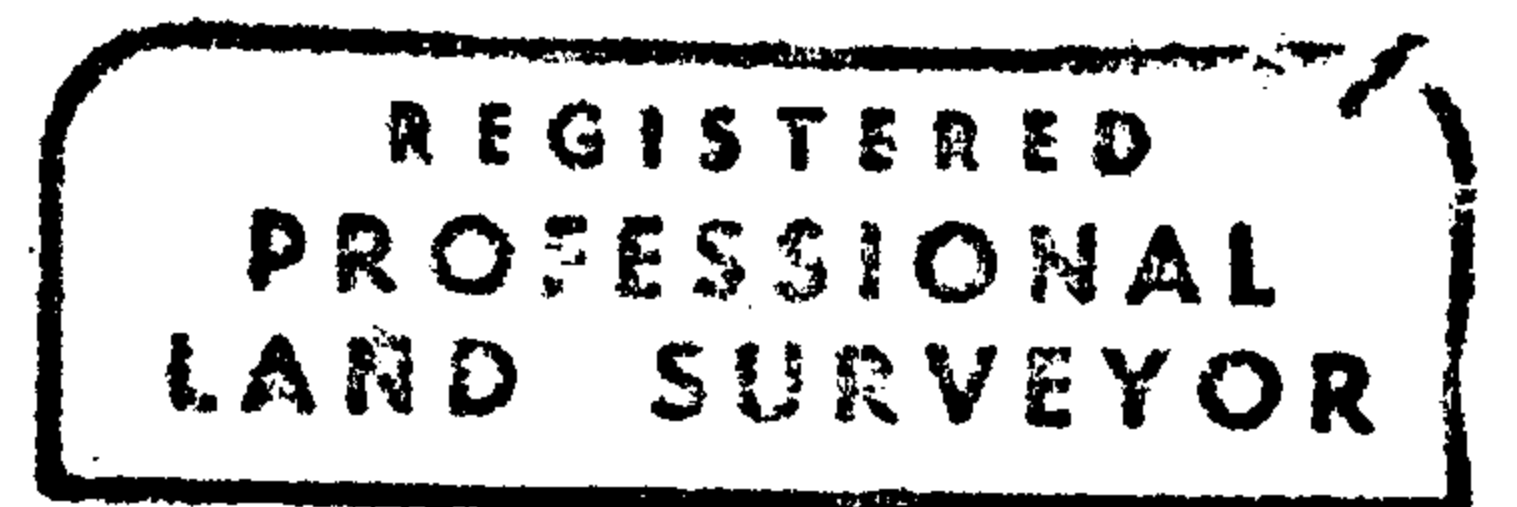

EXP 12-31-18

C.S. File 65/95-34