

FILED

Date: 6/27/2017 By: JC

This survey consists of:

Map: _____

Narrative: _____
Corner Rpt: CS 65/95-35

CORNER REPORT FORM

Section 22 Township 25S Range 8W
Douglas County Date 4-2017
PLSS Number
460400

DOUGLAS COUNTY
SURVEYOR

CORNER DESIGNATION

E 1/16 S15
S22

- Condition Report only
- Not Found
- Renewed
- Unrecorded
- Surveyed In
- Referenced out

Previous Renewals/Surveys, etc:


BLM Dependent Resurvey 1965 Pg 13778
BLM Dependent Resurvey 1989 Pg 18865

Monument(s) & Accessories Found: (Condition and Source)

FD BLM BRASS CAP
20" FIR STUMP N69 1/4 E 528 FT
24" FIR STUMP S54 W 137.9 FT
DOWN & ROTTED 20" FIR N51 E 4.6 FT

Monument Detail

Sketch

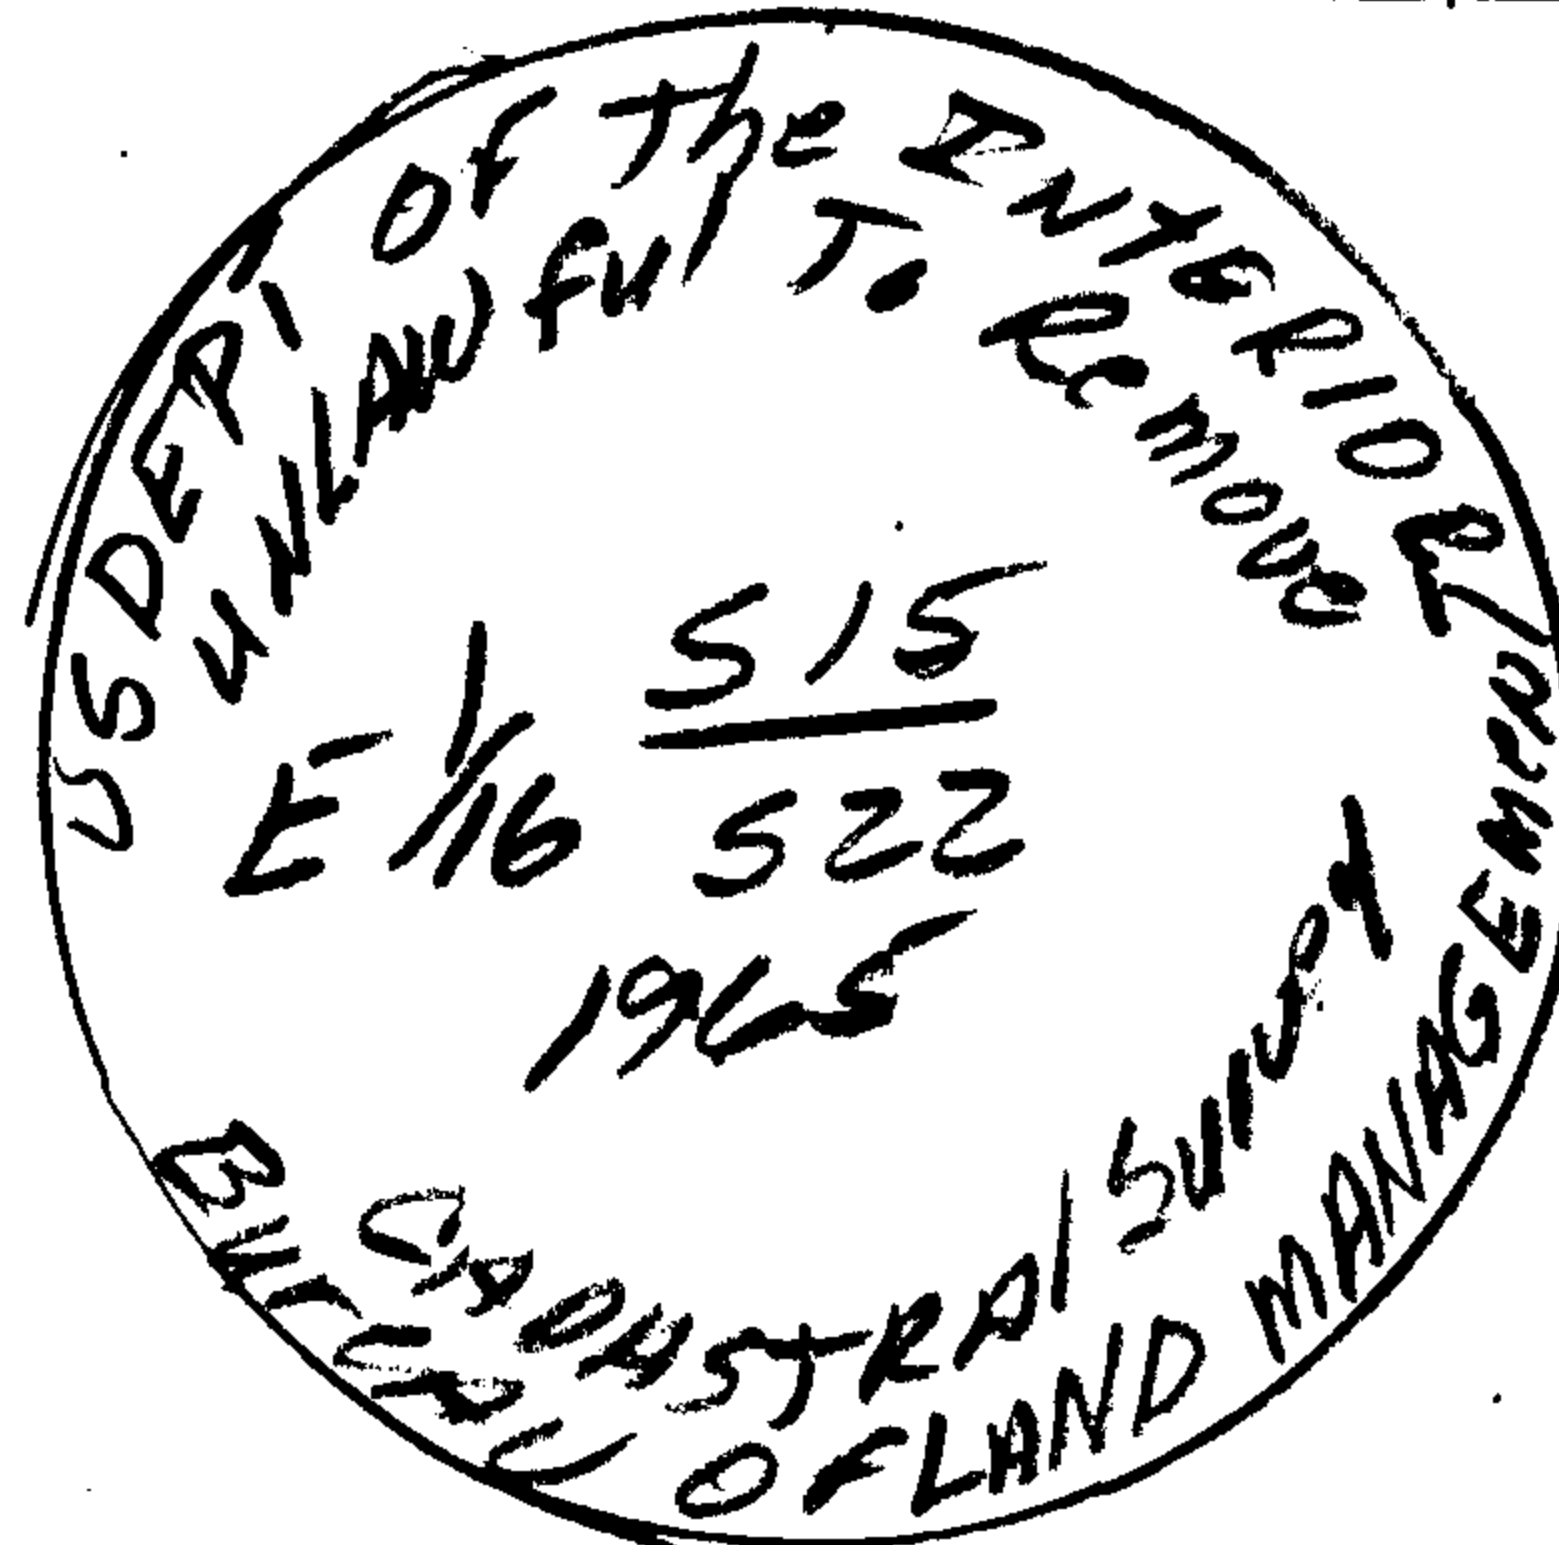

Monument Set (Procedures and Description)



New Accessories

12" FIR N56 E 24.5 FT Scribed E 1/16 S15 BT
10" FIR S81 E 29 FT Scribed E 1/16 S22 BT

Surveyor's Seal

Location & Comments

Compass Declination 15 1/2 E
Firm/Agency: i.e. Engineering, Inc.
Address: 809 SE Pine St., Roseburg, OR 97470
Party Chief: N. Fromdah
Notes:
Witness: R. OLSEN

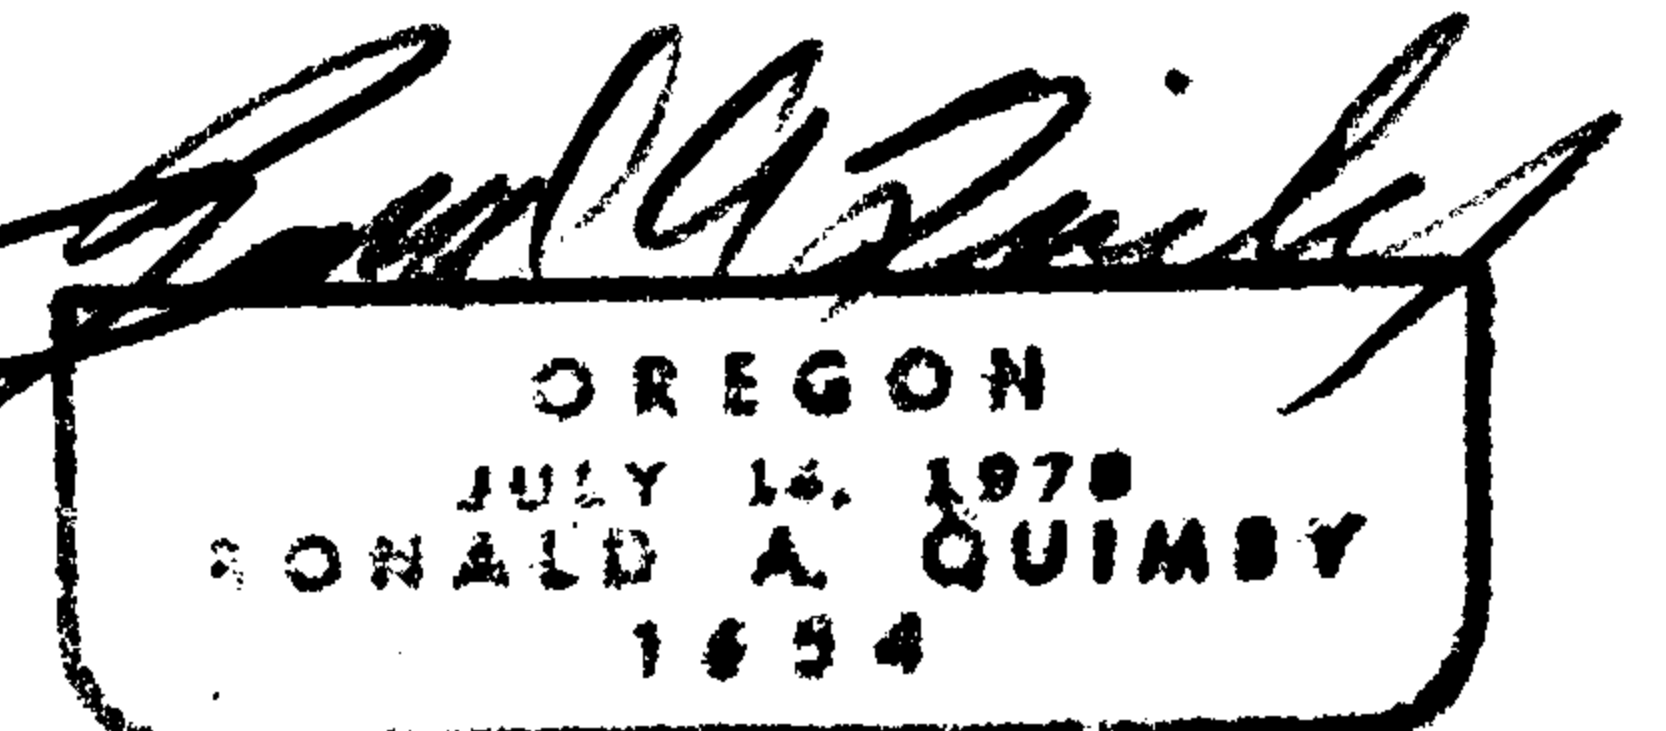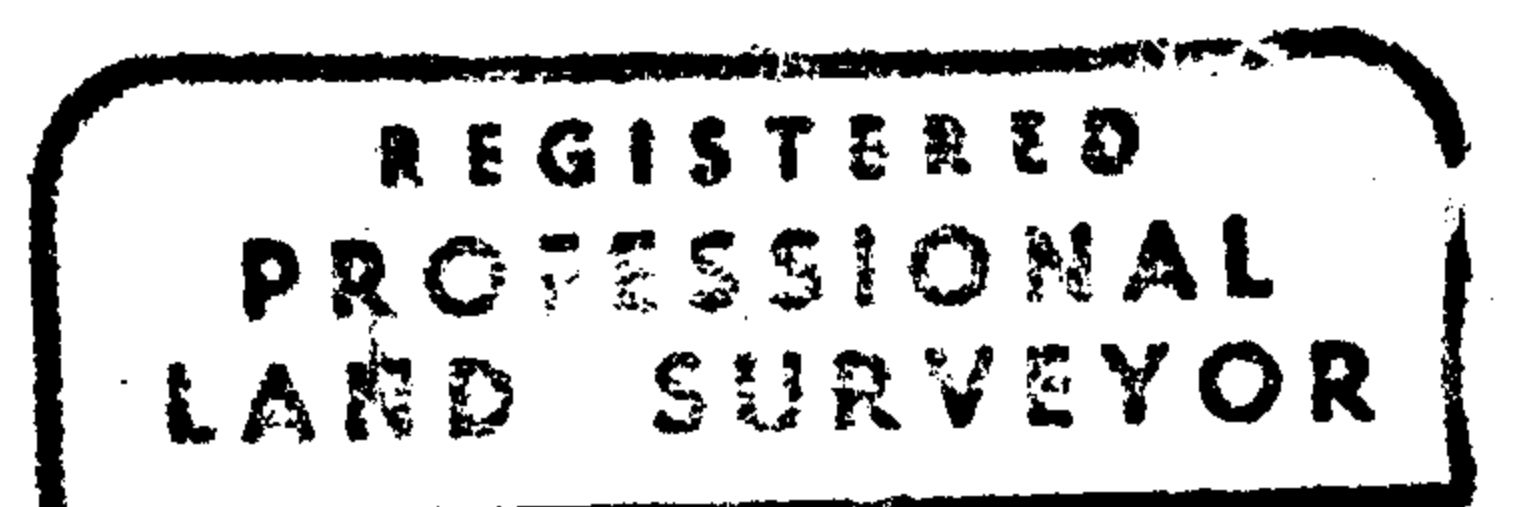

BXP12-31-18

C.S. File 65/95-35