

FILED

Date: 7-6-2017 By: JC

This survey consists of:

Map: _____

Narrative: _____

Corner Rpt: CS 65/95-38

DOUGLAS COUNTY
SURVEYOR

CORNER REPORT FORM

Section 24 Township 25 S Range 2 W
Douglas County Date May 8, 2017
PLSS Number 660320

CORNER DESIGNATION

SE 1/16 corner of SEction 24.

- Condition Report only
- Not Found
- Renewed
- Unrecorded
- Surveyed In
- Referenced out

Previous Renewals/Surveys, etc:

Set by Hosford on survey M 16-5. (Hemlock post)
Iron pipe set by Williams/McChesney in 1975. See C.S. 59/11-9.

Monument(s) & Accessories Found: (Condition and Source)

Found 3/4" diam. iron pipe from 1975.

All of the following found bearing trees are stumps with partial scribing visible.
A 40" Cedar stump bears N. 7° E., 13.7' to "W" nail in face.
An 18" diam. Cedar stump bears N. 74° E., 25.9' to face.
A 33" diam. Cedar stump bears S. 47½° E., 19.0' to face.

Monument Detail

N/A

Sketch

Monument Set (Procedures and Description)

N/A

New Accessories

A 6" diam. Alder bears N. 60° E., 16.9' to center of tree at root crown.
An 11" diam. Fir bears N. 81° W., 19.1' to center of tree at root crown.
Both are scribed "SE 1/16 S24 BT". A six foot steel post is set 2 feet North.

Surveyor's Seal

Location & Comments

Compass Declination 15° East

Firm/Agency: David Edwards Land Surveying


Address: P.O. Box 361

Oakland, Oregon 97462

Party Chief: Brant Miller

Notes: _____

Witness: Eric Sprinkle

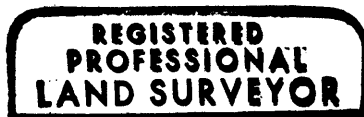

David A. Edwards



Renews 12/31/17

C.S. File 65/95-38