

FILED

Date: 7-6-2017 By: JC

This survey consists of:

Map: _____

Narrative: _____
Corner Rpt: CS 65/95-39

CORNER REPORT FORM

Section 24 Township 25 S Range 2 W
Douglas County Date 5/8/2017
PLSS Number 660360

DOUGLAS COUNTY
SURVEYOR

CORNER DESIGNATION

NE 1/16 corner of Section 24

- ___ Condition Report only
- ___ Not Found
- X Renewed
- ___ Unrecorded
- ___ Surveyed In
- ___ Referenced out

Previous Renewals/Surveys, etc:

Set by Hosford on survey M 16-5. (cedar post)
5/8" diam. rebar w/alum. cap set from Hosford B.T. on M 142-79 by Rice.
Monument(s) & Accessories Found: (Condition and Source)

Found 5/8" diam. rebar w/cap per M 142-79.

Hosford B.T.: A 26" diam. Hemlock stump w/partial scribe visible
bears N. 39 $\frac{1}{2}$ ° W., 23.6' to face.

Rice B.T.: A 9" diam. Cedar w/partial scribe visible bears
N. 33° E., 4.9' to center of tree at root crown.

Monument Detail

Sketch

N/A

Monument Set (Procedures and Description)

N/A

New Accessories

A 10" diam. Fir scribed "NE 1/16 S24 BT" bears N. 39° W., 7.0' to
center of tree at root crown.

A six foot steel post is set 2 feet South.

Surveyor's Seal

Location & Comments

Compass Declination 15° East

Firm/Agency: David Edwards Land Surveying


Address: P.O. Box 361

Oakland, Oregon 97462

Party Chief: Brant Miller

Notes: _____

Witness: Eric Sprinkle

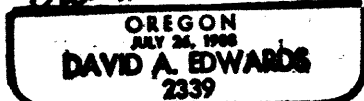

Renews 12/31/17

C.S. File 65/95-39