

FILED

Date: 7-19-2017 By: JC

This survey consists of:

Map: _____

Narrative: CS

Corner Rpt: 65/95-44

**DOUGLAS COUNTY
SURVEYOR**

CORNER REPORT FORM

Section 35 Township 19S Range 9W
Douglas County Date 7/07/2017
PLSS Number 600200

CORNER DESIGNATION

SECTION COR FOR S25, S26, S35 & S36, T19S, R9W

- Condition Report only
- Not Found
- Renewed
- Unrecorded
- Surveyed In
- Referenced out

Previous Renewals/Surveys, etc:

1958 BLM DEPENDENT RESURVEY RESTORED AT PROPORTIONATE DISTANCE PER A 1958 USBLM DEPENDENT RESURVEY, RENEWED PER A 1968-1976 USBLM DEPENDENT RESURVEY AND RENEWED IN 2012 PER CS FILE 65/76-47



Monument(s) & Accessories Found: (Condition and Source)

- FOUND 3-1/4" BRASS CAP
- 38" HEMLOCK NOW 40" STUMP WITH METAL CAP, SCRIBING VISIBLE "T19S R9W S25 BT" BEARS N32-1/4°E 42.9' - 1968 BT
- 37" FIR NOW 32" ROTTING STUMP WITH ROTTED FACE BEARS S36-3/4°W 85.8' - 1968 BT
- 36" FIR NOW 32" ROTTING STUMP WITH ROTTED FACE BEARS N32-1/2°W 66.0' 1968 BT
- 13" D. FIR NOW 14" WITH HEALED FACE BEARS N66°E 5.6' 2012 BT
- 13" D. FIR NOW 15" WITH HEALED FACE BEARS N59°W 14.9' 2012 BT
- 15" D. FIR NOW 16" WITH HEALED FACE BEARS S64°W 13.6' 2012 BT

Monument Detail

3-1/4" BRASS CAP ON 2-1/2" IRON POST

Sketch

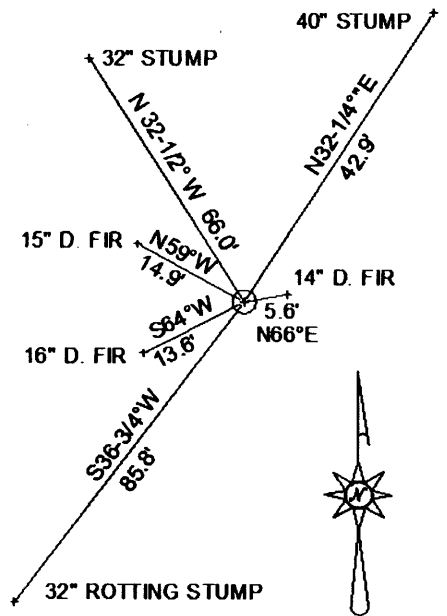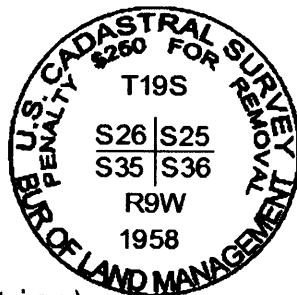

Monument Set (Procedures and Description)

NOTHING SET

New Accessories

SET STEEL FENCE POST WITH BLM LAND SURVEY MARKER SIGN NEAR CORNER

Surveyor's Seal



Location & Comments

BEARINGS ARE BASED ON 1958 BLM SURVEY.

Compass Declination NOT USED
 Firm/Agency: WOBBE & ASSOC. INC
 Address: P.O. BOX 3093
FLORENCE, OREGON
 Party Chief: BRAD FOSTER
 Notes: _____
 Witness: MATTHEW TERNYIK

C.S. File 65/95-44