

FILED

Date: 1-18-2018 By: X

This survey consists of:

Map: _____

Narrative: _____

Corner Rpt: CS 65/95-53

OREGON CORNER RESTORATION FORM

DOUGLAS COUNTY
SURVEYOR

SECTION 21 & 28 TOWNSHIP 20S. RANGE 10 W. W.M.

Corner Designation

1/4 CORNER SECTIONS 21 & 28
GCDB/PLSS CORNER ID No. 340300

Previous Renewals / Surveys, etc.:

CS FILE 42/275, M1-56
CS FILE 55/163, M42-2
CS FILE 65/75-5, M163-55

- Condition Report Only
- Not Found
- Renewed
- Unrecorded
- Surveyed in
- Referenced Out

Monument Detail Sketch

Monument Found or Set (Procedures and Description)

FND. MONUMENT:

A RUSTED 3/4" IRON PIPE PER M42-2.

NEW MONUMENT SET:

SET 5/8" X 30" IRON ROD PLASTIC CAP MARKED "ESTABROOK LS2703"
SET INSIDE 3/4" IRON PIPE.

FND. BT'S:

A 24" FIR WITH HEALED FACE, X-CHOP AND TAG BRS. N70°E 57.0'
TO A SPIKE AT SIDE CENTER.

A 20" FIR WITH HEALED FACE, X-CHOP AND TAG BRS. S44°E 36.4'
TO A SPIKE AT SIDE CENTER.

A 23" MAPLE WITH TAG AND NO OTHER VIS MARKS BRS. S06°30'E 37.4'.

New Accessories

NEW BT MARKED:

A 9" CASCARA BARK SCRIBED "N1/4 S28 BT" WITH X-CHOP AND TAG
BRS. S15°W 5.10' TO A SPIKE AT SIDE CENTER.

Locations & Comments


LAT. AND LONG. PER GARMEN ETREX HAND HELD GPS
N: 43°48'37.6" W: 123°53'49.5"

CENTER OF ROAD BEARS SOUTH 110 FEET.

Compass Declination 18° EAST
Firm / Agency: Estabrook Land Surveying Inc.
Address: PO BOX 574, Lakeside, OR 97449
Party Chief: Jerry Estabrook
Notes:
Witness: Pat Coy & Jed Massey
DATE 7/13/17

Surveyors Seal

REGISTERED
PROFESSIONAL
LAND SURVEYOR

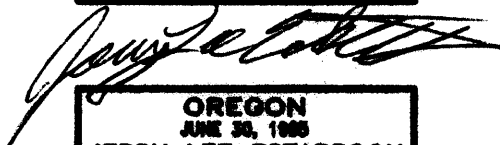

OREGON
JUNE 30, 1999
JERRY LEE ESTABROOK
2703

EXPIRES 12/31/17

C.S. FILE 65/95-53