

CORNER NOTES

AUGUST 3, 2017

BY: TONY HOSTETTER
63538 PINTAIL DR.
COOS BAY, OR 97420

FOR: D.R. JOHNSON LUMBER CO.
PO BOX 66
RIDDLE, OR 97469

NE 1/16 CORNER SECTION 18, T.20 S., R.11W., W.M.

DOUGLAS COUNTY, OREGON

FOUND: 1" IRON PIPE WITH 1963 BRASS CAP AS SET BY HOOTMAN
IN 1963 (M22-36)
HOOTMAN BTS ARE GONE.

NEW BTS:
10" FIR, SCRIBED "S18 1/16 BT", BT TAG,
BEARS; S81°E, 4.8 FEET TO SPIKE.

5"HEMLOCK, SCRIBED "S18 1/16 BT", BT TAG,
BEARS; S 25°W, 12.5 FEET TO SPIKE.

NE 16 20-11-18.DOC

FILED

Date: 1-18-2018 By: JC


This survey consists of:

Map: _____

Narrative: _____

Corner Rpt: CS 65/95-55

DOUGLAS COUNTY
SURVEYOR

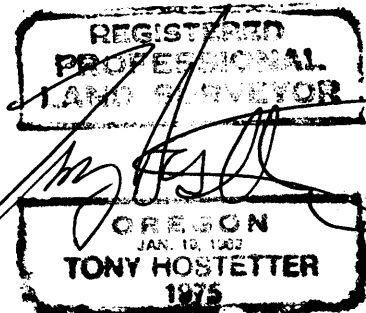

C.S. FILE 65/95-55