

FILED

Date: 1-18-2018 By: SC

This survey consists of:

Map: _____

Narrative: _____

Corner Rpt: C.S. 65/95-59

CORNER REPORT FORM

Section 12 Township 25 S Range 3 W
Douglas County Date 8/30/17
PLSS Number 640500

DOUGLAS COUNTY
SURVEYOR

CORNER DESIGNATION

South 1/4 Corner

- ___ Condition Report only
- ___ Not Found
- X Renewed
- ___ Unrecorded
- ___ Surveyed In
- ___ Referenced out

Previous Renewals/Surveys, etc:

Original: G.L.O. in 1883. Proportion corner set in 1943 by Norman D. Price. (G.L.O.)
1966 D.C.S. Renewal.

Monument(s) & Accessories Found: (Condition and Source)

1943 brass capped iron pipe by G.L.O. found in good condition.
1943 B.T.: A 54" Fir stump bears N. 4° W., 44.2'.
The other 1943 B.T. is gone.
Both 1966 D.C.S. bearing trees are gone.

Monument Detail

Sketch

Standard G.L.O. brass capped iron pipe.

Monument Set (Procedures and Description)

N/A

New Accessories

A 12" diam. Hemlock scribed "1/4 S13 BT" bears S. 64° E., 15.8'.
A 5" diam. Fir scribed "1/4 S12 BT" bears N. 46° W., 6.1'.
Six foot steel posts are set 2 feet N. 84° E. and 2 feet S. 84° W.


Surveyor's Seal

Location & Comments

Compass Declination 15° East
Firm/Agency: David Edwards Land Surveying
Address: P.O. Box 361
Oakland, Oregon 97462
Party Chief: Brant Miller
Notes: _____
Witness: Eric Sprinkle



David A. Edwards

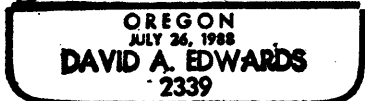

Renews 12/31/17

C.S. File 65/95-59