

FILED

Date: 1-18-2018 By: JC

This survey consists of:

Map: _____

Narrative: _____

Corner Rpt: CS 65/95-60

DOUGLAS COUNTY SURVEYOR

CORNER REPORT FORM

Section 30 Township 31S Range 5W
Douglas County Date 8/17
PLSS Number A0200

CORNER DESIGNATION

1/4 COR 530
531

- Condition Report only
- Not Found
- Renewed
- Unrecorded
- Surveyed In
- Referenced out

Previous Renewals/Surveys, etc:


Gibson 1963 CS 51/264 Smith OSDF 1998 M 129-B

DCSO 1966 Smith OSDF 1995 M 122-17

Monument(s) & Accessories Found: (Condition and Source)

- 3" State Forestry BRASS CAP
 - 42" Rotten Fir Stump N70°E 125 FT
 - 36" uprooted stump S85W 5.9 FT
 - 23" Hemlock Stump (3' HIGH) S26W 25⁸ FT VIS SCRIBES
 - 34" Cedar Stump N24E 28¹ FT
 - 24" Hemlock Stump N29W 61² VIS SCRIBES
 - 26" Hemlock S21°W 31³ FT GOOD SCAR
- 2 CARBONITE POST PER RECORD
Monument Detail

Sketch

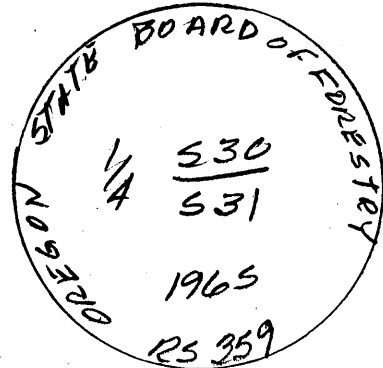

Monument Set (Procedures and Description)

New Accessories

- 15" Cedar N13°E 5⁶ FT Scribed 1/4 530 RT
- 24" Fir S37°E 14⁴ FT Scribed 1/4 531 RT

Surveyor's Seal

Location & Comments

Corner is approx 160' East of Canyon Creek Road Crossing Tag on Road

Compass Declination 15 1/2° E


Firm/Agency: i.e. Engineering, Inc.

Address: 809 SE Pine St., Roseburg, OR 97470

Party Chief: N. Fromdahl

Notes:

Witness: R. OLSEN

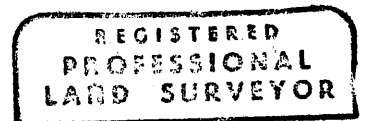

Signature of Ronald A. Quimby

EXP 12-31-18

C.S. File 65/95-60