

MAP OF SURVEY

LOCATED in the NW 1/4 of
Sec. 25, T. 30 S., R. 8 W., W.M.
in Douglas County, Oregon.

April 10, 2017

FILED

Date: 5-1-2017 By: X
This survey consists of:
Map: CS 65'96-6
Narrative: _____
Corner Rpt: _____

DOUGLAS COUNTY
SURVEYOR

SURVEYED FOR: *SENECA JONES TIMBER COMPANY*
P.O. BOX 2129
ROSEBURG, OREGON 97470

SURVEYED BY: *DAVID EDWARDS LAND SURVEYING*
P.O. BOX 361
OAKLAND, OREGON 97462
PHONE: (541) 459-0512



LEGEND

⊙ INDICATES 1985 B.L.M. BRASS CAPPED IRON PIPE FOUND.

() DENOTES RECORD DATA PER 1985 B.L.M. SURVEY.

SCALE: 1" = 500'

BASIS OF BEARINGS: 1985 B.L.M. SUBDIVISION OF SECTION 25 SURVEY AS SHOWN.

NARRATIVE


THE PURPOSE OF THIS SURVEY IS TO MARK THE EAST LINE OF THE SE QUARTER OF THE NW QUARTER OF SECTION 25. A RANDOM TRAVERSE WAS RUN BETWEEN THE CENTER 1/4 CORNER AND THE CENTER-NORTH 1/16 CORNER AND OFFSETS WERE THEN MADE TO THE TRUE LINE. THE LINE WAS MARKED BY BLAZING TREES ON EACH SIDE OF LINE, BY SETTING SIX FOOT STEEL POSTS ALONG THE LINE AT INTERVALS OF 200 FEET OR LESS AND BY HANGING LIBERAL AMOUNTS OF RED FLAGGING ALONG THE TRUE LINE.

FIELD CREW: BRANT MILLER AND ERIC SPRINKLE.

EQUIPMENT: NIKON TOTAL STATION.

COMPUTATIONS AND DRAFTING: DAVID EDWARDS.

CN 1/16 CORNER FOUND.
A 12" DIAM. FIR BEARS S 74° E, 8.9'
A 13" DIAM. FIR BEARS S 22° W, 22.8'
BOTH WITH HEALED BLAZES.
A SIX FOOT STEEL POST IS SET
2 FEET SOUTH ON LINE.

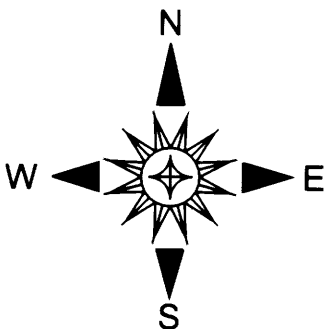

BASE BEARING (1289.64')
N 0°41'00" E 1289.97'

BLAZED AND POSTED THE EAST LINE
OF THE SE 1/4 OF THE NW 1/4 SEC. 25

CTR. 1/4 CORNER FOUND.
AN 8" DIAM. FIR BEARS N 60 1/2° E, 17.2'
A 10" DIAM. FIR BEARS S 39° E, 7.9'
BOTH WITH HEALED BLAZES.
A SIX FOOT STEEL POST IS SET
2 FEET NORTH ON LINE.