


RECORD OF SURVEY
 FOR: CAMPBELL GLOBAL
 NE1/4, SECTION 22, T. 20 S., R.11 W., W.M.
 DOUGLAS COUNTY, OREGON
 30 MAY 2017

FILED
 DATE: 6-19-2017 BY: JC
 THIS SURVEY CONSISTS OF:
 MAP: CS 65/96-10
 NARRATIVE: _____
 CORNER RPT: _____
 DOUGLAS COUNTY
 SURVEYOR

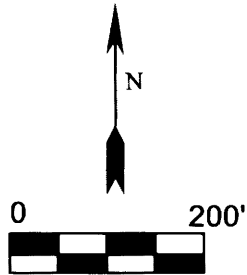


1/4 CORNER SECTIONS 15, 22
 FOUND 1978 BRASS CAP PER CSF M73-7
 WITH THE FOLLOWING ACCESSORIES:
 39" D. FIR BEARS N 84 ° E 67.2' - HEALED FACE
 20" ALDER BEARS S 2° W 37.7' - BARK SCRIBING VISIBLE
 48" D. FIR SNAG BEARS N 0° W 12.2' - NO MARKS
 36" D. FIR STUMP BEARS S 37° E 32.0' - NO MARKS
 CARSONITE POST ADJACENT TO CORNER

E1/16 CORNER SECTIONS 15, 22
 FOUND 1978 USFS ALUMINUM CAP
 WITH THE FOLLOWING ACCESSORIES:
 12" ALDER BEARS S 31° W 13.3' - BARK SCRIBING VISIBLE
 26" D. FIR BEARS S 64° E 109.0' - HEALED FACE
 STEEL POST ADJACENT TO CORNER

LEGEND

- ◄○► FOUND 1/4 CORNER AS NOTED
- FOUND 1/16 CORNER AS NOTED
- [] COUNTY SURVEY FILE M114-29 RECORD DATA
- USFS UNITED STATES FOREST SERVICE
- CSF COUNTY SURVEY FILE

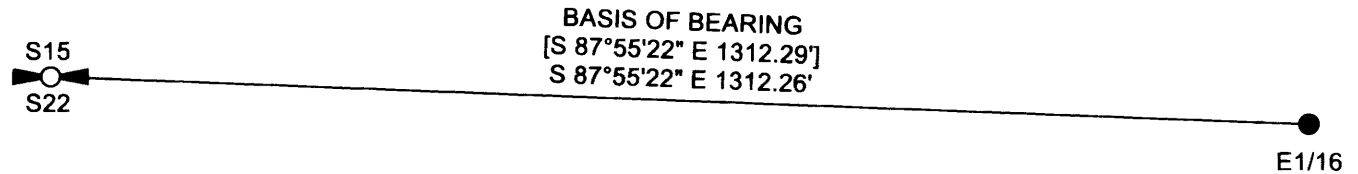

NARRATIVE:

THE PURPOSE OF THIS SURVEY IS TO DOCUMENT THE MARKING OF TRUE LINE AS SHOWN HEREON IN SECTION 22, TOWNSHIP 20 SOUTH, RANGE 11 WEST, WILLAMETTE MERIDIAN.

EXISTING CORNERS WERE TIED BY GROUND TRAVERSE FOR CONTROL AND HELD IN THEIR AS TIED POSITIONS FOR MARKING TRUE LINE. TRUE LINE WAS MARKED WITH RED PAINTED BLAZES, RED FLAGGING AND 5-1/2' GALVANIZED STEEL POSTS SET AT AN AVERAGE INTERVAL OF 200'

THE BASIS OF BEARING FOR THIS SURVEY WAS THE COUNTY SURVEY FILE M114-29

THIS SURVEY WAS PERFORMED USING A NIKON TOTAL STATION.

REGISTERED
 PROFESSIONAL
 LAND SURVEYOR
Ronald L. Rice
 OREGON
 JULY 9, 2002
 RONALD L. RICE
 54633LS

EXPIRATION DATE: 12-31-2018

Northwest Land Surveying, Inc.
 P. O. Box 2827
 FLORENCE, OR 97439 541-997-9201

FILE NAME		
17-059		
SCALE	DATE	DRAWN BY
200 Ft/in	5-30-2017	RLR
JOB	REVISION	SHEET
LEITEL 22	-----	1/1

This map drawn with TRAVERSE PC Software