


RECORD OF SURVEY
 FOR: CAMPBELL GLOBAL
 & D R JOHNSON LUMBER CO.
 NW1/4, SW1/4, SECTION 16,
 T. 20 S., R. 11 W., W.M.
 DOUGLAS COUNTY, OREGON
 8 NOVEMBER 2017




FILED
 DATE: 11/22/2017 BY: JC
 THIS SURVEY CONSISTS OF:
 MAP: CS 65/97-4
 NARRATIVE: _____
 CORNER RPT: _____
 DOUGLAS COUNTY
 SURVEYOR

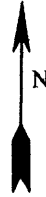

N1/16 CORNER SECTIONS 16, 17
 FOUND 2008 USFS ALUMINUM CAP
 WITH ALL ACCESSORIES PER M146-80

LEGEND

- FOUND 1/4 CORNER AS NOTED
- FOUND SECTION CORNER AS NOTED
- FOUND 1/16 CORNER AS NOTED
- [] RECORD DATA PER M146-80
- DCSO DOUGLAS COUNTY SURVEYORS OFFICE
- USFS UNITED STATES FOREST SERVICE

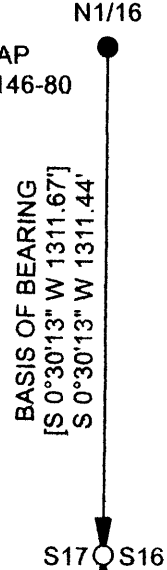

1/4 CORNER SECTIONS 16, 17
 FOUND 1969 DCSO BRASS CAP
 WITH ALL ACCESSORIES PER
 M146-80

NARRATIVE:

THE PURPOSE OF THIS SURVEY IS TO DOCUMENT THE MARKING OF TRUE LINE AS SHOWN HEREON IN SECTION 16, TOWNSHIP 20 SOUTH, RANGE 11 WEST, WILLAMETTE MERIDIAN.

EXISTING CORNERS WERE TIED BY GROUND TRAVERSE FOR CONTROL AND HELD IN THEIR AS TIED POSITIONS FOR MARKING TRUE LINE. TRUE LINE WAS MARKED WITH RED PAINTED BLAZES, RED FLAGGING AND 5-1/2' GALVANIZED STEEL POSTS SET AT AN AVERAGE INTERVAL OF 200'

THE BASIS OF BEARING FOR THIS SURVEY WAS DOUGLAS COUNTY SURVEY FILE M146-80.

THIS SURVEY WAS PERFORMED USING A NIKON TOTAL STATION.

[S 0° 32'38" W 2630.03']
 S 0°33'38" W 2630.15'

SECTION CORNER
 SECTIONS 16, 17, 20, 21
 FOUND 1969 DCSO BRASS CAP
 WITH ALL ACCESSORIES PER
 M146-80



REGISTERED
 PROFESSIONAL
 LAND SURVEYOR

Ronald L. Rice

OREGON
 JULY 9, 2002
 RONALD L. RICE
 54633LS

Northwest Land Surveying, Inc.
 P. O. Box 2827
 FLORENCE, OR 97439 541-997-9201

FILE NAME		
17-104		
SCALE	DATE	DRAWN BY
500 Ft/In	11-8-2016	RLR
JOB	REVISION	SHEET
LEITEL 16	-----	1/1

EXPIRATION DATE: 12-31-2018

This map drawn with TRAVERSE PC Software