

**NARRATIVE:**

THE PURPOSE OF THE SURVEY WAS TO MONUMENT THE NORTHWEST CORNER OF THE PROPERTY DESCRIBED IN DEED REFERENCE NO. 2011-4468 OF THE DEED RECORDS OF DOUGLAS COUNTY, OREGON.

THE WESTERLY BOUNDARY OF LOT 9, BLOCK 5, HOUSELY HEIGHTS WAS DETERMINED BY THE FOUND ORIGINAL MONUMENTS AS SHOWN. THE CORNER OF SET AT RECORD DISTANCE ALONG SAID WEST BOUNDARY.

**LEGEND**

- FOUND ORIGINAL MONUMENT PER HOUSELY HEIGHTS (VOL. 8, PG. 17) AS NOTED.
- SET 5/8"X30" IRON ROD W/ PLASTIC CAP MARKED "LAND MARK PLS2287"

**RECORD INFO.**

- ( ) HOUSELY HEIGHTS (VOL.8, PG. 17)

S89° 27' 41"E 199.93' (200.00')  
BASIS OF BEARINGS PER  
HOUSLEY HEIGHTS (V.8, PG. 17)


REGISTERED  
PROFESSIONAL  
LAND SURVEYOR

*Mark A. Heimbürger*

OREGON  
JULY 16, 1987  
MARK A. HEIMBURGER  
2287

RENEWS JUNE 30, 2019

FILED  
Date: 5/21/2018 By: JC  
This survey consists of:  
Map: CS 65/98-5  
Narrative: \_\_\_\_\_  
Corner Rep: \_\_\_\_\_  
**DOUGLAS COUNTY  
SURVEYOR**

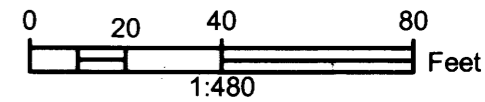

SCALE: 1" = 40'

Record of Survey  
Lots 9 & 10, Block 5, Housely Heights  
SW 1/4, SEC. 12, T. 27 S., R. 06 W., W.M.  
Douglas County, Oregon  
04/05/2018

FOR: City of Roseburg  
900 SE Douglas Ave  
Roseburg, Oregon 97470  
LM Proj. No. 2018-0016

Land Mark  
SURVEYING INC.  
3329 N.E. STEPHENS ST.  
ROSEBURG, OREGON 97470  
TEL (541) 677-9400  
FAX (541) 677-9401

Sheet 1 of 1

C.S. FILE 65/98-5