

FILED

Date: 1-18-2018 By: JC

This survey consists of:

Map: \_\_\_\_\_

Narrative: \_\_\_\_\_

Corner Rpt: LS 65/99-3

CORNER REPORT FORM

Section 33 Township 30S Range 7W  
Douglas County Date 9. 2017  
PLSS Number 340100

DOUGLAS COUNTY  
SURVEYOR

CORNER DESIGNATION

SO. 1/4 SEC 33 ONLY

- Condition Report only
- Not Found
- Renewed
- Unrecorded
- Surveyed In
- Referenced out

Previous Renewals/Surveys, etc:

GLD 1918 Vol 17 PG. 7292-93  
DCSO 1965 CS 53/40  
Smalley 2000 M 134-7  
Monument(s) & Accessories Found: (Condition and Source)

1918 GLD BEASS CIP ON IRON PIPE  
20" FIR N56°E 323 FT VIS. SCAR  
14" PINE S43°E 342 FT FAINT SCRIBES  
OTHER BT'S OF RECORD ARE BURNED OUT.

Monument Detail



Sketch

Monument Set (Procedures and Description)

New Accessories

14" PINE S27°W 56 FT Scriber 1/4 S33 BT  
18" PINE N37°W 53 FT Scriber 1/4 S33 BT



Location & Comments

AREA BADLY BURNED  
8/2017

Compass Declination 15 1/2° E  
Firm/Agency: i.e. Engineering, Inc.  
Address: 809 SE Pine St., Roseburg, OR 97470

Party Chief: R. Olsen  
Notes:  
Witness: J. Leonard

Surveyor's Seal

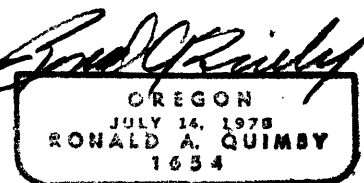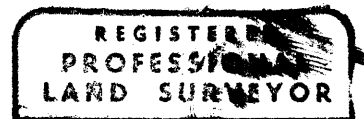

EXP 12-31-18

C.S. File 65/99-3