

FILED

Date: 1-18-2018 By: JC

This survey consists of:

Map: _____

Narrative: _____

Corner Rpt: CS 65/99-4

CORNER REPORT FORM

Section 33 Township 30 S Range 7 W

Douglas County

Date 9-2017

PLSS Number 340140

DOUGLAS COUNTY SURVEYOR

CORNER DESIGNATION

C 1/4

- Condition Report only
- Not Found
- Renewed
- Unrecorded
- Surveyed In
- Referenced out


Previous Renewals/Surveys, etc:

SET BY SMALLEY M 194-7 2000

Monument(s) & Accessories Found: (Condition and Source)

- 2" ALUM. CAP ON 5/8" I. ROD
- 24" FIR N28°W 25 FT GOOD SCAR
- 18" MADRONA N72°E 9 FT HEALED SCRIBE
- 10" MADRONA S89°W 32 FT HEALED SCRIBE
- 18" FIR N89°E 54 FT GOOD SCAR (NOW SNA9)

Monument Detail

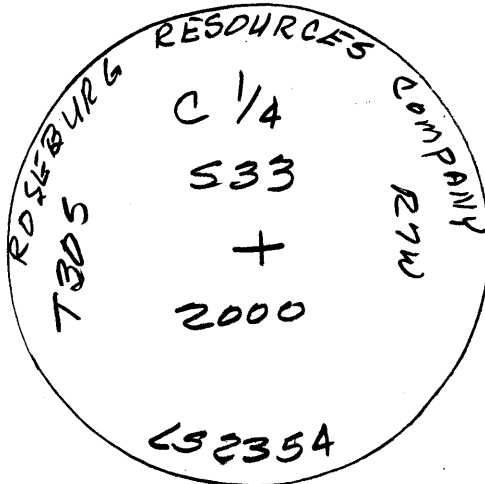

Sketch

Monument Set (Procedures and Description)

New Accessories

18" MADRONA S60°E 43 FT scribed C 1/4 BT

Surveyor's Seal

Location & Comments

AREA BADLY BURN + 8-2017

Compass Declination 15 1/2° E


Firm/Agency: i.e. Engineering, Inc.

Address: 809 SE Pine St., Roseburg, OR 97470

Party Chief: R OLSEN

Notes:

Witness: J. LEONARD

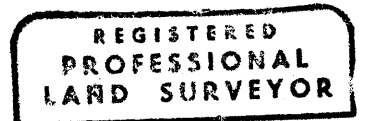

Ronald A. Quimby
 OREGON
 JULY 14, 1978
 RONALD A. QUIMBY
 1554

EXP 12-31-18

C.S. File 65/99-4