

FILED

Date: 1-18-2018 By: JC

This survey consists of:

Map: \_\_\_\_\_

Narrative: \_\_\_\_\_

Corner Rpt: CS 65/99-14

DOUGLAS COUNTY  
SURVEYOR

CORNER REPORT FORM

Section 30 Township 30 S Range 7 W  
Douglas County Date 10/2017  
PLSS Number  
120200

CORNER DESIGNATION

W 1/4 30  
31

- Condition Report only
- Not Found
- Renewed
- Unrecorded
- Surveyed In
- Referenced out

Previous Renewals/Surveys, etc:

SET BY JOHNSTONE 197-28

Monument(s) & Accessories Found: (Condition and Source)

FD 2" ALUM CAP ON 5/8" I. ROD  
19" FIR S 73° W 19 FT GOOD SCAR  
7" FIR N 20° W 8 FT GOOD SCAR (DEAD BURNT)

Monument Detail

Sketch

NO MARKING ON ALUM CAP

Monument Set (Procedures and Description)

New Accessories

12" MADRONA 141 E 9 FT scribed W 1/16 S 30 BT

Location & Comments

AREA BADLY  
BURNT 9/2017

Compass Declination 15 1/2 ° E

Firm/Agency: i.e. Engineering, Inc.


Address: 809 SE Pine St., Roseburg, OR 97470

Party Chief: J. LEONARD


Notes:

Witness: R. OLSEN

Surveyor's Seal

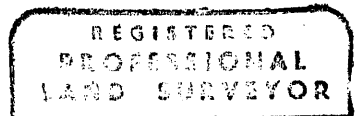

*[Signature]*

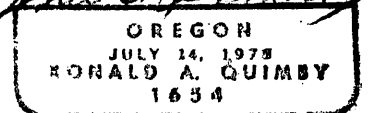

EXP 12-31-18

C.S. File 65/99-14