

FILED

Date: 1-18-2018 By: X

This survey consists of:

Map: \_\_\_\_\_

Narrative: \_\_\_\_\_

Corner Rpt: CS65/99-15

DOUGLAS COUNTY  
SURVEYOR

CORNER REPORT FORM

Section 30 Township 30S Range 7W  
Douglas County Date 10/2017  
PLSS Number  
120260

CORNER DESIGNATION

NW 1/16 S30

- Condition Report only
- Not Found
- Renewed
- Unrecorded
- Surveyed In
- Referenced out


Previous Renewals/Surveys, etc:

SET by Johnstone in 97-28

Monument(s) & Accessories Found: (Condition and Source)

Fd 2" ALUM CAP ON 5/8" I. ROD  
19" FIR EAST 5 3/4 FT GOOD SCAR  
16" FIR S72°W 15 1/4 FT 6000 SCAR

Monument Detail

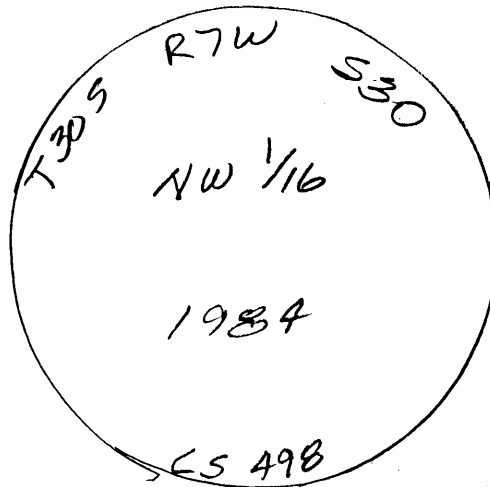

Sketch

Monument Set (Procedures and Description)



New Accessories

Location & Comments

COR IS JUST EAST  
OF RIDGE TOP AND  
APPROX 400' SOUTH  
OF ROAD.  
AREA BADLY  
BURNED  
9/2017

Compass Declination 15 1/2° E  
Firm/Agency: i.e. Engineering, Inc.  
Address: 809 SE Pine St., Roseburg, OR 97470  
Party Chief: J. LEONARD  
Notes:  
Witness: D JENKINS

Surveyor's Seal

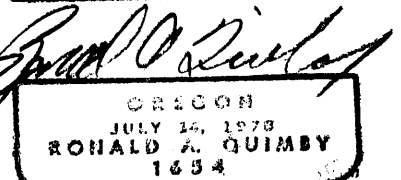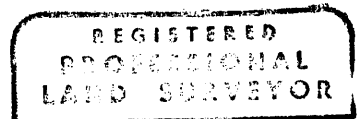

EXP 12-31-18

C.S. File 65/99-15