

FILED

Date: 1-18-2018 By: JC

This survey consists of:

Map: _____

Narrative: _____

Corner Rpt: CS65/99-16

DOUGLAS COUNTY SURVEYOR

CORNER REPORT FORM

Section 30 Township 30S Range 7W
Douglas County Date 10/2017
PLSS Number 1A0200

CORNER DESIGNATION

1/4 COR 30
31

- Condition Report only
- Not Found
- Renewed
- Unrecorded
- Surveyed In
- Referenced out


Previous Renewals/Surveys, etc:

GLD Survey 1918 Vol 17 pg 7296-97
DCSB 1965 CS 53/40 Johnstone 1984 m 97-28

Monument(s) & Accessories Found: (Condition and Source)

Fd 1918 GLD BRASS CAP ON 1" I.P
4 buried out root holes

Monument Detail

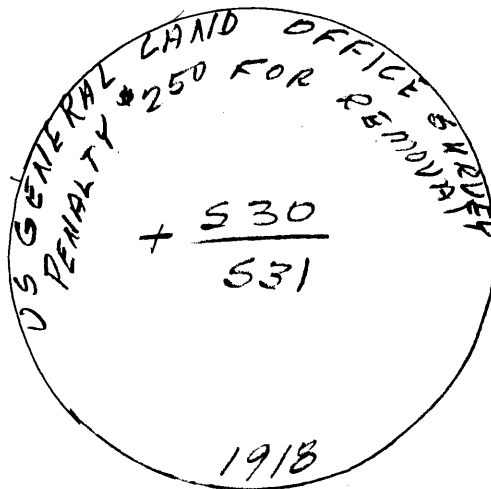

Sketch

Monument Set (Procedures and Description)

New Accessories

N 42° W	12'
S 35° E	21'
N 39° E	22'
S 39° W	21'

CHIPS STAMPED REENGINEERING
set IRROD with yellow Plastic Caps
set 5' ALUM. Post Along side I. RODS

"	"
"	"
"	"

Surveyor's Seal

Location & Comments

AREA RADIALLY
BURNT 9/2017

Compass Declination 15 1/2° E

Firm/Agency: i.e. Engineering, Inc.

Address: 809 SE Pine St., Roseburg, OR 97470

Party Chief: J. Leonard

Notes:

Witness:

REGISTERED PROFESSIONAL LAND SURVEYOR

Ronald A. Quimby

OREGON
JULY 14, 1978
RONALD A. QUIMBY
1654

EXP 12-31-18

C.S. File CS65/99-16