

FILED

Date: 1-18-2018 By: SC

This survey consists of:

Map: _____

Narrative: _____
Corner Rpt: CS 65/99-17

DOUGLAS COUNTY
SURVEYOR

CORNER REPORT FORM

Section 30 Township 30S Range 7W
Douglas County Date 10/2017
PLSS Number 140200

CORNER DESIGNATION

E 1/4 30
31

- Condition Report only
- Not Found
- Renewed
- Unrecorded
- Surveyed In
- Referenced out


Previous Renewals/Surveys, etc:

SET BY JOHNSTONE 1197-28

Monument(s) & Accessories Found: (Condition and Source)

FD 2" ALUM CAP ON 5/8" I ROD
22" CEDAR S13E 11 1/2 FT GOOD SCAR (DEAD BURN)
26" FIR N88E 21 1/2 FT GOOD SCAR (DEAD BURN)

Monument Detail

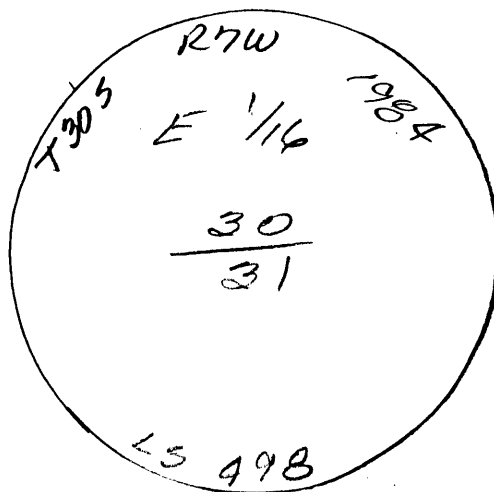

Sketch

Monument Set (Procedures and Description)

New Accessories

CAPS STAMPED I.E. ENGINEERING
5/8" I.R. WITH YELLOW PLASTIC CAP N60°W 6 3/4 FT
5/8" I.R. WITH YELLOW PLASTIC CAP S60°E 8 3/4 FT
SET 5" ALUM POST BY EACH I. ROD

Surveyor's Seal

Location & Comments

AREA BADLY
BURNED 9/2017

Compass Declination 15 1/2° E


Firm/Agency: I.E. Engineering, Inc.

Address: 809 SE Pine St., Roseburg, OR 97470

Party Chief: J. LEONARD

Notes:

Witness: R. OLSEN

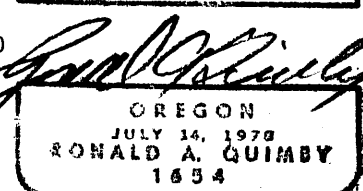

EXP 12-31-18

C.S. File CS 65/99-17