

FILED

Date: 1-18-2018 By: XC

This survey consists of:

Map: _____

Narrative: _____
Corner Rpt: CS 65/99-18

DOUGLAS COUNTY
SURVEYOR

CORNER REPORT FORM

Section 30 Township 30S Range 7W
Douglas County Date 10/2017
PLSS Number 160220

CORNER DESIGNATION

SE 1/16 S30

- Condition Report only
- Not Found
- Renewed
- Unrecorded
- Surveyed In
- Referenced out


Previous Renewals/Surveys, etc:

SET by Johnston M 97-28

Monument(s) & Accessories Found: (Condition and Source)

Fd 2" Alum CAP ON 5/8 I.R.
18" FIR S 76° E 72 FT GOOD SCAR (DEAD)
24" FIR N 16° E 25 FT GOOD SCAR (DEAD)

Monument Detail

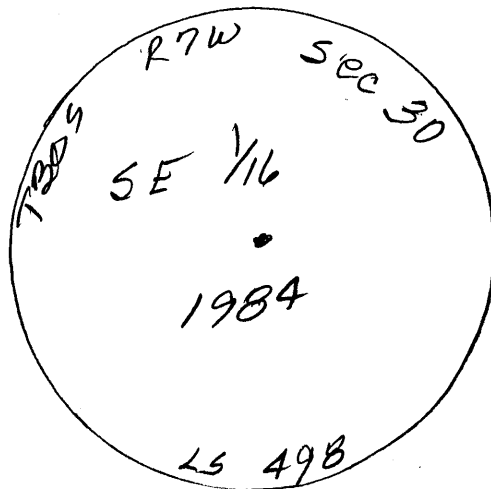

Sketch

Monument Set (Procedures and Description)

New Accessories

CAPS STAMPED IEC ENGINEERING

5/8" T. ROD with yellow PLASTIC CAP N 33° E 9 1/2 FT

5/8" I. ROD with yellow PLASTIC CAP S 35° W 78 FT

5' Alum Post by T. Rod's

Surveyor's Seal

Location & Comments

CORNER IS APPROX
20' EAST OF
GRAVEL ROAD
AREA BORNLY
Burnt 9/2017

Compass Declination 15 1/2° E
Firm/Agency: i.e. Engineering, Inc.
Address: 809 SE Pine St., Roseburg, OR 97470
Party Chief: J. LEONARD
Notes:
Witness: R. OLSEN



Ronald A. Quimby
GREGON
JULY 14, 1978
RONALD A. QUIMBY
1984

Exp 12-31-18

C.S. File 65/99-18