

FILED

Date: 1-18-2018 By: JC

This survey consists of:

Map: _____

Narrative: _____

Corner Rpt: CS 65/99-19

CORNER REPORT FORM

Section 30 Township 30S Range 7W
Douglas County Date 10/2017
PLSS Number 200220

DOUGLAS COUNTY
SURVEYOR

CORNER DESIGNATION

S 1/16 30/29

- Condition Report only
- Not Found
- Renewed
- Unrecorded
- Surveyed In
- Referenced out

Previous Renewals/Surveys, etc:


SET BY JOHNSTONE M 97-28

Monument(s) & Accessories Found: (Condition and Source)

Fd W.C. Alum. CAP ON 5/8" I.R. 30' North of Corner
14" FIR N 12°W 10.0 FT GOOD SCAR
16" FIR N 89°W 37.2 FT GOOD SCAR

Monument Detail

Sketch

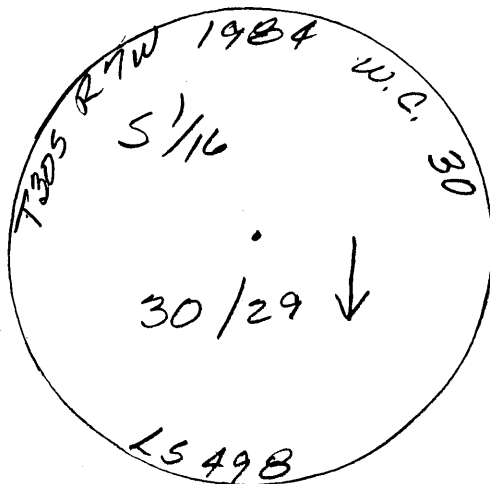

Monument Set (Procedures and Description)



New Accessories

Surveyor's Seal

Location & Comments

W.C. IS APPROX
40' North of
GRAVEL ROAD
AREA BADLY
BURN T 9/20 17

Compass Declination 15 1/2 °E
Firm/Agency: i.e. Engineering, Inc.
Address: 809 SE Pine St., Roseburg, OR 97470
Party Chief: J. LEOPARD
Notes:
Witness: R. OLSEN

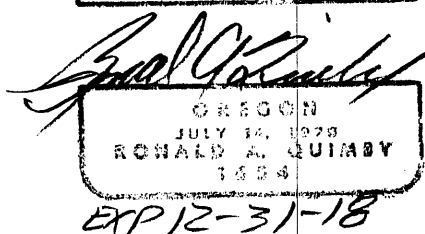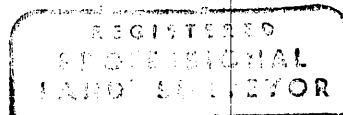

C.S. File 65/99-19