

FILED

Date: 1-18-2018 By: JC

This survey consists of:

Map: \_\_\_\_\_

Narrative: \_\_\_\_\_

Corner Rpt: CS 65/99-20

DOUGLAS COUNTY SURVEYOR

CORNER REPORT FORM

Section 32 Township 30S Range 7W  
Douglas County Date 10/2017  
PLSS Number 240160

CORNER DESIGNATION

CN 1/16

- Condition Report only
- Not Found
- Renewed
- Unrecorded
- Surveyed In
- Referenced out


Previous Renewals/Surveys, etc:

Johnstone 1984 1795-50

Monument(s) & Accessories Found: (Condition and Source)

2" Alum CAP ON 5/8" I. ROD  
30" FIR 529°W 11 1/2 FT GOOD SCAR  
16" FIR N46°E 26 1/2 FT GOOD SCAR

Monument Detail

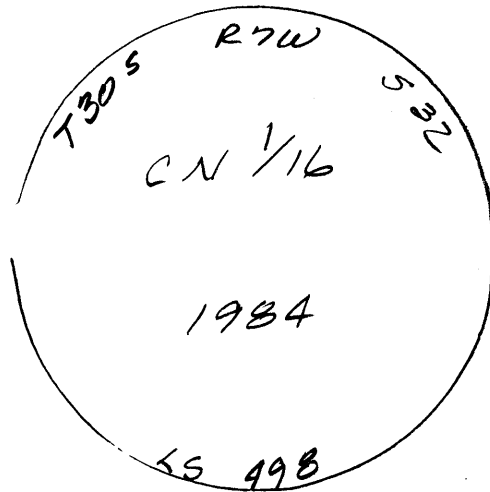

Sketch

Monument Set (Procedures and Description)



New Accessories

Location & Comments

CORNER IS APPROX  
200' EAST OF A  
N-S RIDGE TOP  
AREA BADLY  
BURNED 9/2017

Compass Declination 15 1/2° E  
Firm/Agency: i.e. Engineering, Inc.  
Address: 809 SE Pine St., Roseburg, OR 97470  
Party Chief: J. LEONARD  
Notes:  
Witness: R. OLSEN

Surveyor's Seal

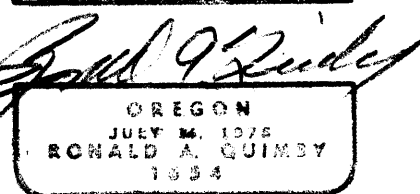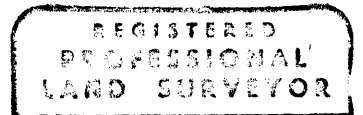

EXP 12/31/18

C.S. File 65/99-20