

FILED

Date: 1-18-2018 By: X

This survey consists of:

Map: \_\_\_\_\_

Narrative: \_\_\_\_\_

Corner Rpt: CS65/99-22

DOUGLAS COUNTY  
SURVEYOR

CORNER REPORT FORM

Section 32 Township 30S Range 7W  
Douglas County Date 10/2017  
PLSS Number 260160

CORNER DESIGNATION

NE 1/16 S 32


Previous Renewals/Surveys, etc:

JOHNSTONE 1984 M 97-50

Monument(s) & Accessories Found: (Condition and Source)

Ed 2" ALUM CAP ON 5/8" I. ROD  
8" OAK 512W 34? GOOD SCAR  
12" FIR NORTH 11E " "

Monument Detail

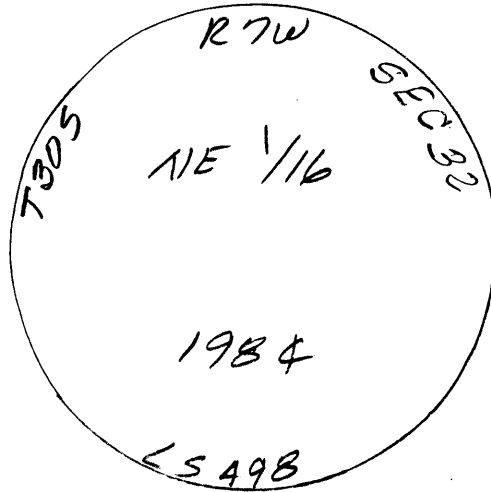

Sketch

Monument Set (Procedures and Description)



New Accessories

Location & Comments

Set Post 05  
West of Corner  
AREA BND 1/4  
BURNT 9/2017

Compass Declination 15 1/2 ° E  
Firm/Agency: i.e. Engineering, Inc.  
Address: 809 SE Pine St., Roseburg, OR 97470  
Party Chief: J. LEONARD  
Notes:  
Witness: R. OLSEN

Surveyor's Seal

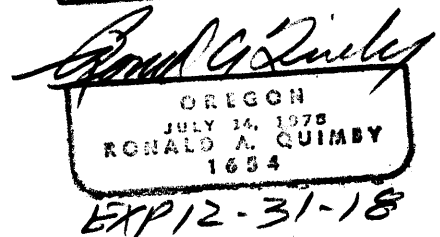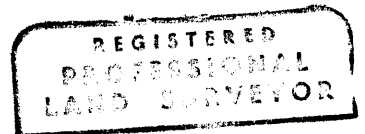

C.S. File 65/99-22