

FILED

Date: 1-18-2018 By: SC

This survey consists of:

Map: _____

Narrative: _____

Corner Rpt: CS 65/99-23

DOUGLAS COUNTY
SURVEYOR

CORNER REPORT FORM

Section 32 Township 30S Range 7W

Douglas County

Date 10/2017

PLSS Number
260440

CORNER DESIGNATION

CE 1/16 532

- Condition Report only
- Not Found
- Renewed
- Unrecorded
- Surveyed In
- Referenced out


Previous Renewals/Surveys, etc:

JOHNSTON 1984 M97-50

Monument(s) & Accessories Found: (Condition and Source)

2" ALUM. CAP ON 5/8" I. ROD
12" OAK N 24° E 27 1/2 FT FACE OPEN BURNT OUT
Root Hole N 126 W 54

Monument Detail

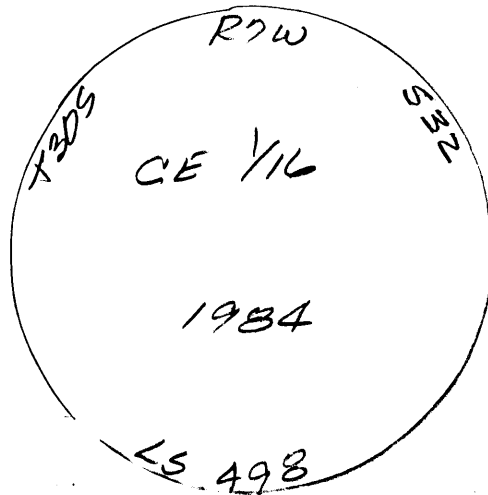

Sketch

Monument Set (Procedures and Description)

New Accessories

4" DIA STONE N 110° W 14 1/2 FT WITH PK NAIL

Surveyor's Seal

Location & Comments


AREA BADLY
BURNT 9/2017

Compass Declination 15 1/2° E
Firm/Agency: i.e. Engineering, Inc.
Address: 809 SE Pine St., Roseburg, OR 97470

Party Chief: J. LEONARD

Notes:

Witness: R. OLSON

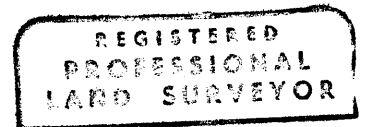

Ronald A. Gimby
 OREGON
 JULY 14, 1978
 RONALD A. GIMBY
 1654

EXP 12-31-18

C.S. File 65/99-23