

FILED

Date: 1-18-2018 By: X

This survey consists of:

Map: _____

Narrative: _____

Corner Rpt: C565/99-26

CORNER REPORT FORM

Section 22 Township 31S Range 7W

Douglas County

Date 10/2017

PLSS Number 400340

DOUGLAS COUNTY
SURVEYOR

CORNER DESIGNATION

1/4 COR S21/S22



Condition Report only
Not Found
Renewed
Unrecorded
Surveyed In
Referenced out


Previous Renewals/Surveys, etc:

BLM RESURVEY 1964 V0133 PB 13634-35
DCSO 1996 CS 65/9-11

Monument(s) & Accessories Found: (Condition and Source)

BLM BRASS CAP ON 2 1/2" I.P.I.C
38" PINE STUMP S52W 128 FT (NO MARKS)
55" PINE STUMP S58E 137 FT (NO MARKS)
27" FIR STUMP N26E 28 FT HEALED BLAZE
29" FIR N87W 20 FT HEALED SCAR
16" FIR S3E 10 FT HEALED SCAR

Monument Detail

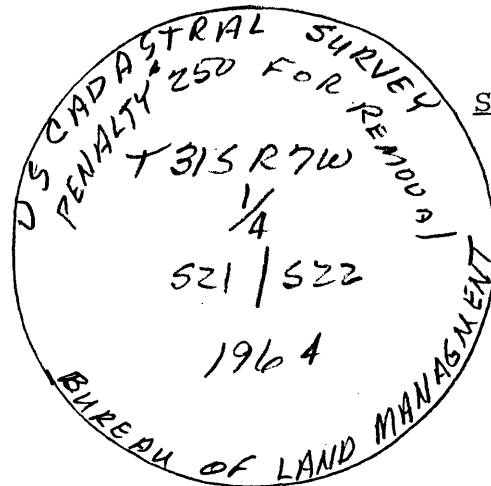

Monument Set (Procedures and Description)

New Accessories

6" FIR S70E 5 FT Scribed 1/4 S22 BT

Surveyor's Seal

Location & Comments

CORNER IS APPROX
450' SOUTH OF A
GRAVEL ROAD AND
150' EAST OF A
CREEK FLOWING S.E
AREA BURNED
9/2017

Compass Declination 15 1/2 E


Firm/Agency: i.e. Engineering, Inc.

Address: 809 SE Pine St., Roseburg, OR 97470

Party Chief: J. LEONARD

Notes:

Witness: R. OLSEN

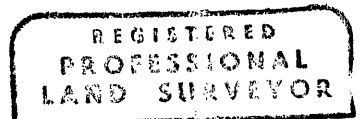

Ronald A. Quimby
OREGON
JULY 14, 1978
RONALD A. QUIMBY
1654

EXP 12-31-18

C.S. File 65/99-26