

FILED

Date: 1-18-2018 By: X

This survey consists of:

Map: _____

Narrative: _____

Corner Rpt: CS 65/99-30


CORNER REPORT FORM

Section 30 Township 28S Range 7W
Douglas County Date 11-2017
PLSS Number 1A0240

DOUGLAS COUNTY
SURVEYOR

CORNER DESIGNATION

C 1/4 530

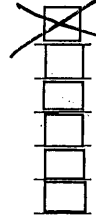

Condition Report only
Not Found
Renewed
Unrecorded
Surveyed In
Referenced out


Previous Renewals/Surveys, etc:

SET PER PARTITION 1996-0004
M138-72 2001 LANDMARK

Monument(s) & Accessories Found: (Condition and Source)

1 1/2" Alum CAP ON 5/8" I. ROD
I. ROD WITH PLASTIC CAP BEARS N45°W 23³ FT
I. ROD WITH PLASTIC CAP BEARS S35°W 20⁸ FT
22" D. FIR N35°E 29³ FT GOOD SCAR (REC N56W)
14" D. FIR S45°E 42³ FT GOOD SCAR (REC S32E)

Monument Detail

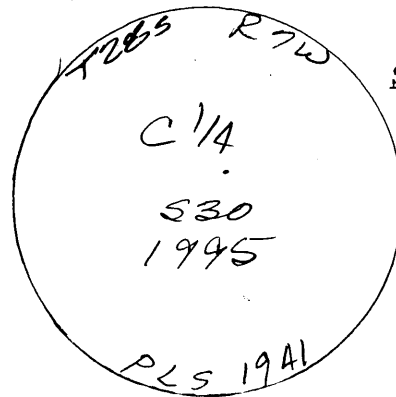

Sketch

Monument Set (Procedures and Description)



New Accessories

Surveyor's Seal

Location & Comments

Compass Declination 15 1/2° E
Firm/Agency: i.e. Engineering, Inc.
Address: 809 SE Pine St., Roseburg, OR 97470

Party Chief: N. Fromdahl
Notes:
Witness: R. Heichel

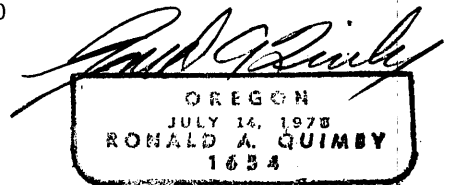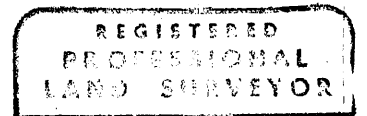

EXP 12-31-18

C.S. File 65/99-30