

FILED

Date: 1-18-2018 By: JC

This survey consists of:

Map: _____

Narrative: _____

Corner Rpt: CS65/99-32

CORNER REPORT FORM

Section 14 Township 30S Range 2W
Douglas County Date 11-2017
PLSS Number 600440

DOUGLAS COUNTY
SURVEYOR

CORNER DESIGNATION

1/4 COR 14/13 W.C.

- Condition Report only
- Not Found
- Renewed
- Unrecorded
- Surveyed In
- Referenced out

Previous Renewals/Surveys, etc:

DCSO 1968

Monument(s) & Accessories Found: (Condition and Source)

2 1/2" DCSO BRASS CAP
 BROKEN 24" LAUREL N20°E 20.5 FT OPEN FACE
 24" CEDAR N60W 18' FT WOOD SCAR
 - 22" D. FIR S43°E 19' FT (Rec 1968)
 T. Post 2' North
 T. Post 3' west

Monument Detail

Sketch

T30S R2W
 wit. cor. 5' south to
 1/4 S14 S13
 1968



Monument Set (Procedures and Description)

New Accessories

Surveyor's Seal

Location & Comments

Compass Declination 15 1/2° E
 Firm/Agency: i.e. Engineering, Inc.
 Address: 809 SE Pine St., Roseburg, OR 97470
 Party Chief: N From Dahl
 Notes:
 Witness: R. Heichel

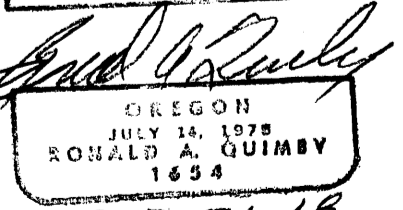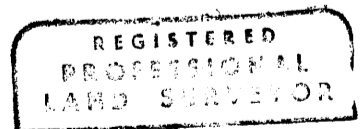

EXP 12-31-18

C.S. File 65/99-32