

FILED

Date: 1-18-2018 By: X

This survey consists of:

Map: _____

Narrative: _____

Corner Rpt: CSCS/99-34

DOUGLAS COUNTY
SURVEYOR

CORNER REPORT FORM

Section 6 Township 30S Range 1 W
Douglas County Date 12/30/2017
PLSS Number 140660

CORNER DESIGNATION

Center-North 1/16 corner

- Condition Report only
- Not Found
- Renewed
- Unrecorded
- Surveyed In
- Referenced out

Previous Renewals/Surveys, etc:

Set on M 117-62 in 1993.

Monument(s) & Accessories Found: (Condition and Source)

Found 2 1/2" diam. alum. pipe with cap in good condition as per M 117-62.

A 13" diam. Pine stump bears S. 72° E., 66.7 feet.

A 23" diam. Pine stump bears S. 30° W., 38.7 feet.

Monument Detail

Sketch

N/A

Monument Set (Procedures and Description)

N/A

New Accessories

An 8" diam. Pine scribed "CN 1/16 S6 BT" bears N. 29° E., 51.3 feet.

A 6" diam. Pine scribed "CN 1/16 S6 BT" bears N. 50° W., 73.5 feet.

A six foot steel post is set 2 feet East.

Surveyor's Seal

Location & Comments

Compass Declination 15° East

Firm/Agency: David Edwards Land Surveying


Address: P.O. Box 361

Oakland, Oregon 97462


Party Chief: Brant Miller

Notes: _____

Witness: Eric Sprinkle

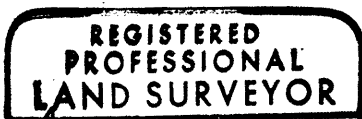

David A. Edwards

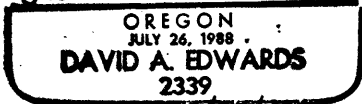

Renews 12/31/19

C.S. File 65/99-34