

FILED

Date: 1-18-2018 By: X

This survey consists of:

Map: _____

Narrative: _____

Corner Rpt: CSGS 99-35

CORNER REPORT FORM

Section 18 Township 31 S Range 7 W
Douglas County Date 12/13/2017
PLSS Number 200440

DOUGLAS COUNTY
SURVEYOR

CORNER DESIGNATION

1/4 corner common to
Sections 18 and 17

- ___ Condition Report only
- ___ Not Found
- X Renewed
- ___ Unrecorded
- ___ Surveyed In
- ___ Referenced out

Previous Renewals/Surveys, etc:

Original: W.H. Byars in 1882.

SPACE

Set on line between Section corners using call to R.R. by Lecklider on M 23-68 in 1962.

Monument(s) & Accessories Found: (Condition and Source)


Lecklider's pipe/cap not found.

Lecklider's B.T.'s found:

A 19" diam. Fir with 2 healed blazes bears S.32°E., 19.5 feet.

A 26" diam. Fir with partial bark scribbling visible bears S.1°W., 36.0 feet.

Monument Detail

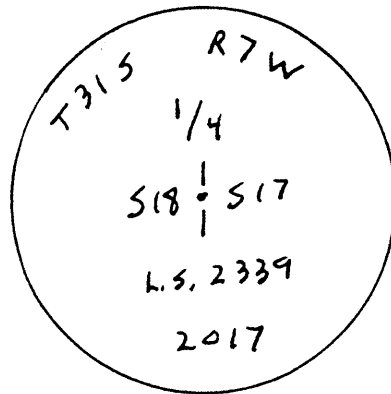

Sketch

Monument Set (Procedures and Description)

Set a 5/8" x 30" steel rebar with 2 1/2" diam. aluminum cap marked per the 2009 B.L.M. manual and marked "L.S. 2339" and "2017" using the record bearings and distances from M 23-68. (from the found bearing trees).

New Accessories

A six foot steel post is set 2 feet North.

Surveyor's Seal

Location & Comments

REGISTERED
PROFESSIONAL
LAND SURVEYOR

David A. Edwards
OREGON
JULY 26, 1988
DAVID A. EDWARDS
2339

Renews 12/31/17

Compass Declination 15° East

Firm/Agency: David Edwards Land Surveying

Address: P.O. Box 361

Oakland, Oregon 97462

Party Chief: Brant Miller

Notes: _____

Witness: Eric Sprinkle

C.S. File CS/99-35