

FILED

Date: 1-18-2018 By: JC

This survey consists of:

Map: _____

Narrative: _____

Corner Rpt: CSGS/99-37

CORNER REPORT FORM

Section 10 Township 31S Range 7W
Douglas County Date 12-2017
PLSS Number 400520

DOUGLAS COUNTY
SURVEYOR

CORNER DESIGNATION

S 1/16 S9/S10

- Condition Report only
- Not Found
- Renewed
- Unrecorded
- Surveyed In
- Referenced out

Previous Renewals/Surveys, etc:


Johnstone M 90-34 1982

Monument(s) & Accessories Found: (Condition and Source)

ALUM. CAP ON 5/8" I. ROD
20" MADRONE N 13 1/2° E 14' FT GOOD SCAR
18" FIR S 54° W 7' FT GOOD SCAR

Monument Detail

Sketch

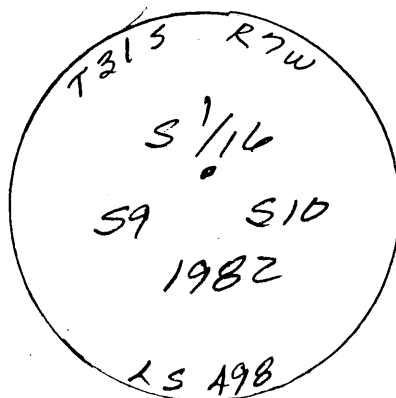

Monument Set (Procedures and Description)

New Accessories

Location & Comments

CORNER IS APPROX
500' North of
RD 31-7-17.1
AREA badly burnt
9-2017

Compass Declination 15 1/2° E

Firm/Agency: i.e. Engineering, Inc.



Address: 809 SE Pine St., Roseburg, OR 97470

Party Chief: N. Fromdahl

Notes:

Witness: R. Heiche 1

Surveyor's Seal

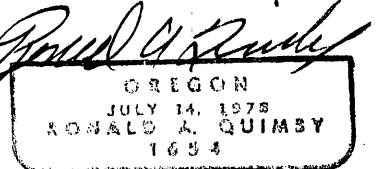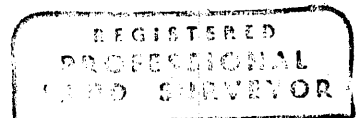

EXP 12-31-18

C.S. File 65/99-37