

FILED

Date: 1-18-2018 By: JC

This survey consists of:

Map: _____

Narrative: _____

Corner Rpt: 69 65/99-38

DOUGLAS COUNTY SURVEYOR

CORNER REPORT FORM

Section 10 Township 2/S Range 7W
Douglas County Date 12-2017
PLSS Number A00540

CORNER DESIGNATION

1/4 59/510

- Condition Report only
- Not Found
- Renewed
- Unrecorded
- Surveyed In
- Referenced out


Previous Renewals/Surveys, etc:

DCSO 1971 CS File 54/96-30 DCSO 1983 CS File 62/7
BLM Resurvey V. 59 PG 15743-1977
BLM Resurvey V. 42 PG 16554-55/1979

Monument(s) & Accessories Found: (Condition and Source)

52" ORIG. COA Tree REMOVED BURNT STUMP
2 1/2" DCSO BRASS CAP ALONG SIDE BURNT STUMP
2 1/2" BRASS CAP (BRNT) N45°W 28' (REC 29)

Monument Detail

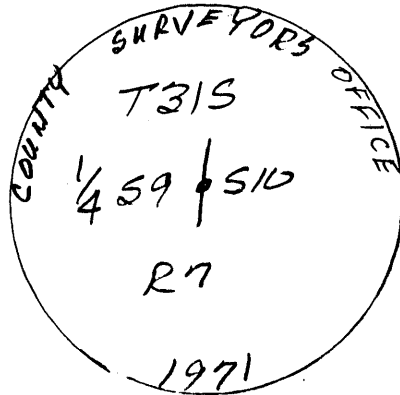

Sketch

Monument Set (Procedures and Description)

New Accessories


PK AND CHISELED X IN E' Vert Rock FACE 558°E 183 FT
10" FIR S45°W 338 FT scribed 1/4 59 BT
12" FIR N45°W 342 FT scribed 1/4 59 BT

Surveyor's Seal

Location & Comments

CORNER IS APPROX
165' NORTH OF SMALL
CREEK FLOW N.W
AREA Badly burnt
9-2017

Compass Declination 15 1/2° E
Firm/Agency: i.e. Engineering, Inc.
Address: 809 SE Pine St., Roseburg, OR 97470
Party Chief: N. Fromdahl
Notes:
Witness: R. Heichel

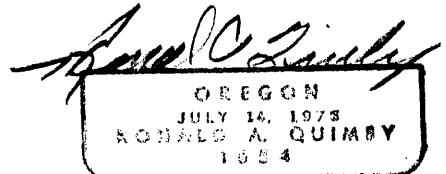

EXP 12-31-18

C.S. File 65/99-38