

FILED

Date: 1-18-2018 By: JC

This survey consists of:

Map: \_\_\_\_\_

Narrative: \_\_\_\_\_

Corner Rpt: CS 65/99-42

CORNER REPORT FORM

Section 14 Township 21S Range 7W  
Douglas County Date 12-2017  
PLSS Number 500500

DOUGLAS COUNTY  
SURVEYOR

CORNER DESIGNATION

Sec COR 10/11  
15/14

- Condition Report only
- Not Found
- Renewed
- Unrecorded
- Surveyed In
- Referenced out


Previous Renewals/Surveys, etc:

Kerr Eng #2125 1951 CS 40/344 BLM Corrective Resurvey  
DCSD 1970 CS 54/36-14  
BLM Resurvey 1974 Vol 39 Pg 15736 1979 V42 Pg 16551

Monument(s) & Accessories Found: (Condition and Source)

2 1/2" DCSD BRASS CAP.  
BURNT STUMP S16°E 23 1/2 FT  
BURNT STUMP 4' TAIL S73°W 35° (TIN CAP)  
46" FIR SNA9 N7°E 25 1/2 FT GOOD SCAR  
21" FIR SNA9 S28E 24 1/2 FT GOOD SCAR  
32" FIR SNA9 N72°W 62 1/2 FT GOOD SCAR

Monument Detail

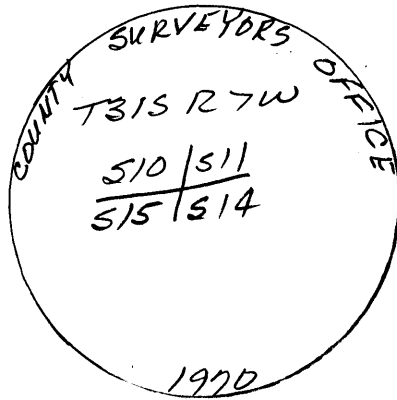

Sketch

Monument Set (Procedures and Description)

New Accessories

40" FIR N68°E 37 1/2 FT BARK Scribed T31S R7W 511 BT  
5/8" I. ROD N60°W 9 1/2 FT All I. Rod have yellow Plastic Caps  
5" I. Rod S60°E 14 1/2 FT ICE ENGINEERING & Post along Side  
5/8" I. Rod S61°W 15 1/2 FT  
Surveyor's Seal

Location & Comments

CORNER IS APPROX  
50' SOUTH OF  
SMALL CREEK FLOWING  
EAST  
AREA BADLY BURNT  
9-2017

Compass Declination 15 1/2° E  
Firm/Agency: i.e. Engineering, Inc.  
Address: 809 SE Pine St., Roseburg, OR 97470  
Party Chief: J. LEONARD  
Notes:  
Witness: R. OLSEN



*Ronald A. Quimby*  
OREGON  
JULY 6, 1978  
RONALD A. QUIMBY  
1984  
EXP 12-31-18

C.S. File 65/99-42