

FILED

Date: 7-11-2018 By: JC

This survey consists of:

Map: _____

Narrative: _____

Corner Rpt: CS 65/101-3

DOUGLAS COUNTY
SURVEYOR

CORNER REPORT FORM

Section 35 Township 22 S Range 7 W
Douglas County Date Jan. 8, 2018
PLSS Number 520140

CORNER DESIGNATION

Center-West 1/16 Corner

- ___ Condition Report only
- ___ Not Found
- X Renewed
- ___ Unrecorded
- ___ Surveyed In
- ___ Referenced out

Previous Renewals/Surveys, etc.:

Set by the B.L.M. in 1984.

Monument(s) & Accessories Found: (Condition and Source)

Found a standard B.L.M. brass capped iron pipe in good condition.

A 42" diam., 3 foot tall Fir stump with visible scribing
bears S. 73° E., 62.0 feet.

A 13" diam. Fir with healed blaze bears S. 18 1/2° E., 32.3 feet.

Monument Detail

Sketch

Standard B.L.M. brass capped iron pipe.

Monument Set (Procedures and Description)

N/A

New Accessories

A 6" diam. Fir scribed "CW 1/16 S35 BT" bears N. 24° E., 6.1 feet.

Surveyor's Seal

Location & Comments

Compass Declination 15° East

Firm/Agency: David Edwards Land Surveying

Address: P.O. Box 361


Oakland, Oregon 97462

Party Chief: Brant Miller

Notes: _____

Witness: Eric Sprinkle

C.S. File 65/101-3

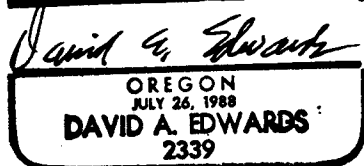

OREGON
JULY 26, 1988
DAVID A. EDWARDS
2339

Renews 12/31/19