

FILED

Date: 7-11-2018 By: JK

This survey consists of:

Map: _____

Narrative: _____
Corner Rpt: CS65/101-4

CORNER REPORT FORM

Section 8 Township 25 S Range 2 W
Douglas County Date 3/14/2018
PLSS Number 220520

DOUGLAS COUNTY
SURVEYOR

CORNER DESIGNATION

SW 1/16 Corner

- Condition Report only
- Not Found
- Renewed
- Unrecorded
- Surveyed In
- Referenced out

Previous Renewals/Surveys, etc:

Set on M 13-13. Renewed on C.S. 53/112-11 and C.S. 65/23-14.
CS 42/398

Monument(s) & Accessories Found: (Condition and Source)

Found 1 1/2" diam. iron pipe in good condition.

Found bearing trees as per C.S. 65/23-14.

Monument Detail

N/A

Sketch

Monument Set (Procedures and Description)


N/A

New Accessories

A 10" diam. Hemlock scribed "SW 1/16 S8 BT" bears N. 62° W., 6.6'
A six foot steel post is set 2' North.

Surveyor's Seal

Location & Comments

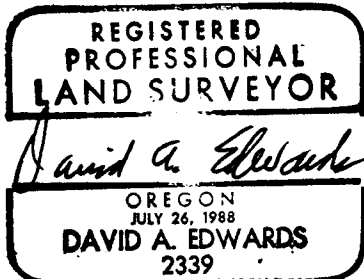

Renews 12/31/19

Compass Declination 15° E

Firm/Agency: David Edwards Land Surveying

Address: P.O. Box 361

Oakland, Oregon 97462

Party Chief: Brant Miller

Notes: _____

Witness: Eric Sprinkle

C.S. File 65/101-4