

FILED

Date: 7-11-2018 By: X

This survey consists of:

Map: _____

Narrative: _____

Corner Rpt: C565/101-8

DOUGLAS COUNTY
SURVEYOR

CORNER REPORT FORM

Section 18 Township 23S Range 5 W
Douglas County Date 5/14, 2018
PLSS Number _____

CORNER DESIGNATION

NW 1/16 Section 18

- ___ Condition Report only
- ___ Not Found
- X Renewed
- ___ Unrecorded
- ___ Surveyed In
- ___ Referenced out

Previous Renewals/Surveys, etc.:

Set on M 118-60

Monument(s) & Accessories Found: (Condition and Source)

Found 2" diam. Iron pipe with brass cap.

A 39" Fir stump bears N 2° W, 26.2'

A 12" Fir stump bears S 38° W, 24.1'

Monument Detail

N/A

Sketch

Monument Set (Procedures and Description)

N/A

New Accessories

A 7" Fir scribed "NW 1/16 S18 BT" bears N 54° W, 13.85'

A 6" Fir scribed "NW 1/16 S18 BT" bears S 1° E, 7.0'

Surveyor's Seal

Location & Comments

Compass Declination 15° East

Firm/Agency: David Edwards Land Surveying


Address: P.O. Box 361

Oakland, Oregon 97462


Party Chief: Brant Miller

Notes: _____

Witness: Eric Sprinkle

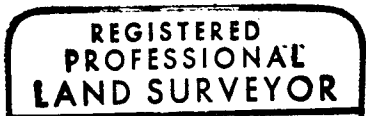

David A. Edwards

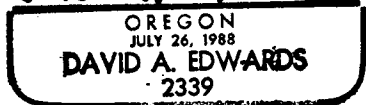

Renews 12/31/19

C.S. File 65/101-8