

FILED

Date: 7-11-2018 By: XC

This survey consists of:

Map: _____

Narrative: _____

Corner Rpt: CS 65/101-13

CORNER REPORT FORM

Section 4 Township 27S Range 3W

Douglas County Date 12-2017

PLSS Number 300640

DOUGLAS COUNTY
SURVEYOR

CORNER DESIGNATION

1/4 COR 5/4

- Condition Report only
- Not Found
- Renewed
- Unrecorded
- Surveyed In
- Referenced out

Previous Renewals/Surveys, etc:

STUNTNER CS 58/53

EDWARDS CS 65/61-2

Ball m 60-48

EDWARDS m 138-18 & CS 65/34-8

Monument(s) & Accessories Found: (Condition and Source)

5/8" I. Rod

3/4" I. PIPE N 0° 31' E 16 67

16" OAK N 55° E 89 8 FT (REC N 55 1/2 E)

18" OAK S 83° E 61 1 FT

Steel Post 1.8' South

Monument Detail

Sketch

Monument Set (Procedures and Description)

New Accessories

Surveyor's Seal

Location & Comments

Compass Declination 15 1/2° E



Firm/Agency: i.e. Engineering, Inc.

Address: 809 SE Pine St., Roseburg, OR 97470

Party Chief: N. Fromdahl

Notes:

Witness: R. Heichel R. VINCENT

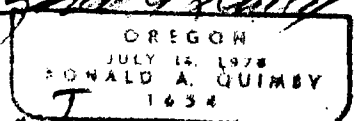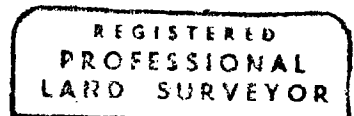

EXP 12-31-18

C.S. File 65/101-13