

FILED

Date: 7-11-2018 By: DC

This survey consists of:

Map: _____

Narrative: _____

Corner Rpt: CS 65/101-16

CORNER REPORT FORM

Section 4 Township 27S Range 3W
Douglas County Date 12-2017
PLSS Number 340640

DOUGLAS COUNTY
SURVEYOR

CORNER DESIGNATION

C 1/4 S4

- Condition Report only
- Not Found
- Renewed
- Unrecorded
- Surveyed In
- Referenced out

Previous Renewals/Surveys, etc:

SET BY BALL M 6048
EDWARDS CS 65/61-2

Monument(s) & Accessories Found: (Condition and Source)

5/8" I. ROD
6" Forked CEDAR SW 17'-FT GOOD SCAR (15" Fork
South)
Steel Posts 2' North & 2' West
20" Pipe S30°E 13 1/2 FT GOOD SCAR

Monument Detail

Sketch

Monument Set (Procedures and Description)

New Accessories

Location & Comments

Compass Declination 15 1/2° E

Firm/Agency: i.e. Engineering, Inc.

Address:


809 SE Pine St., Roseburg, OR 97470

Party Chief: N. Fromidahl

Notes:

Witness: R. Heichel R. HINDEN Exp 12-31-18

Surveyor's Seal

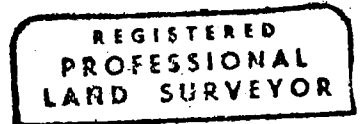

Ronald A. Quimby
OREGON
JULY 14, 1978
RONALD A. QUIMBY
1634

C.S. File 65/101-16